IREDELL COUNTY HEALTH DEPARTMENT

STATESVILLE 704-878-5305 MOORESVILLE 704-664-5281

IMPROVEMENT PERMIT / AUTHORIZATION TO CONSTRUCT / OPERATION PERMIT / EXISTING SYSTEM INSPECTION

PERMIT# 144338 PIN# 4872171265 DATE 8-29-07

OWNER OR APPLICANT Daniel Allen PHONE: Business _____ Home 704 546

ADDRESS 176 York Spur

LOCATION 21 N (L) on Houstonville, (R) Troy Mill, (L) York Spur on (R)

SUBDIVISION n/a BLOCK / SECTION _____ LOT _____ LOT AREA 1.518 SITE CLASS. PS DESIGN FLOW 360 L.T.A.R. .4 Ex.

Septic Tank: Ex. Gallons: STB Ex. Date Ex.

Pump Tank: _____ Gallons: PT _____ Date _____

Pump Make: _____ Model _____ Serial No. _____

Nitrification Field: No Fields Ex Square Feet Ex. Linear Feet Ex.

No Lines Ex. Trench Width Ex. Max Trench Bottom Depth Ex. Gravel Depth Ex.

☐ New System ☐ Repair ☐ Expansion System Type: I II III IV V VI

System Description: Ex.

Repair System Description: Ex.

Maintenance Agreement Required: ☐ Yes ☑ No

☐ Gravity ☐ Pressure

☐ House/Mod. Home ☑ Mobile Home ☐ Business ☐ Other

No. Bedrooms 3 No. Persons ____ No. Employees ____

Water Supply: ☑ Individual ☐ Public ☐ Community

☐ Slab ☑ Crawl Space ☐ Basement w/plumbing ☐ Basement wo/plumbing


Comments:/Conditions:

Comments:/Conditions:

Replace Broken Risers.
New Home sits exactly on old home site

INITIAL SITE SKETCH

AS BUILT SKETCH

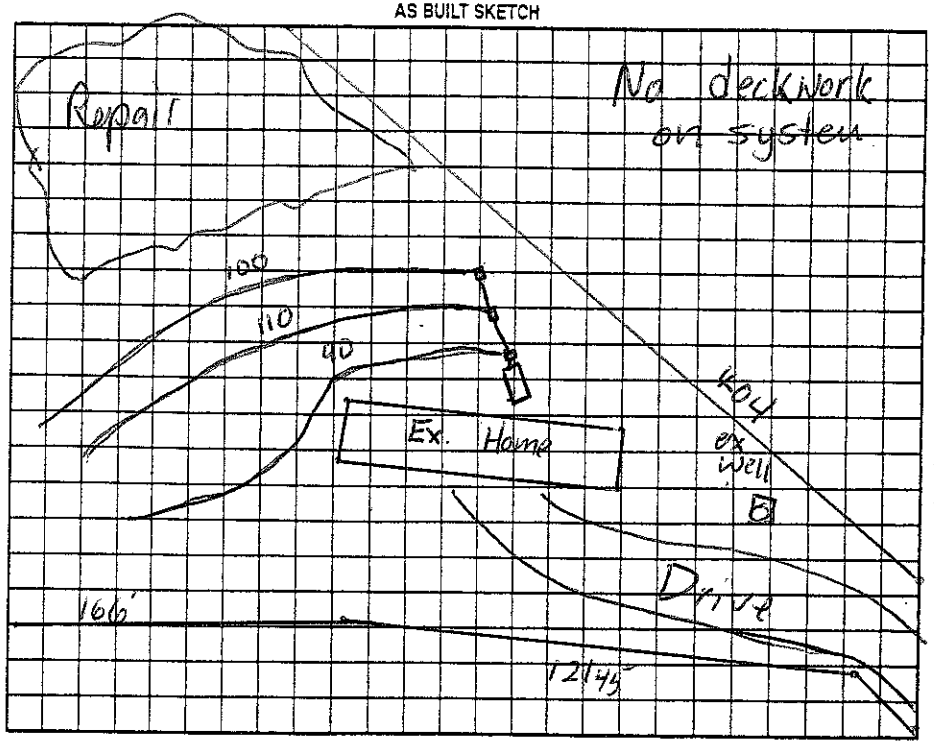

Permit can be suspended or revoked if any false information is supplied toward securing the permit/any unauthorized changes are made to the site/any unauthorized changes are made in the installation of the system. Improvement Permit with plat valid without expiration ☐ Improvement Permit with site plan valid for sixty months ☐ Authorization to Construct is valid for a period equal to that of Improvement Permit – not to exceed sixty months.

Signed: Daniel A. Allen date 9-5-07

Installed by: Ex.

Improvement Permit by: _____ date _____

Operation Permit by: _____ date _____

Authorization to Construct by: _____ date _____

Existing System Inspection by: _____ date 8-29-07

HEALTH DEPT. COPY: WHITE OWNER COPY (FINAL): YELLOW OWNER COPY (INITIAL): PINK