# IREDELL COUNTY HEALTH DEPARTMENT

STATESVILLE 704-878-5305 MOORESVILLE 704-664-5281

## IMPROVEMENT PERMIT / AUTHORIZATION TO CONSTRUCT / OPERATION PERMIT / EXISTING SYSTEM INSPECTION

PERMIT# Repair PIN# DATE 5-17-99

OWNER OR CONTRACTOR Dwight W Padgett PHONE: Business Home 546-7650

ADDRESS 673 Rabbit Hwy Harmony NC

LOCATION 651 Rabbit Hwy - 2i N TL Little Wilkesboro TR Rabbit Hwy last B/ch house on (L)

SUBDIVISION BLOCK / SECTION LOT LOT AREA SITE CLASS P/S DESIGN FLOW 240 L.T.A.R.

Septic Tank: 1000 Gallons; STB Date

Pump Tank: 6x Gallons; PT Date

Pump Make: Model Serial No.

Nitrification Field: No Fields 1 Square Feet 600 Linear Feet 200

No Lines 2 Trench Width 36in Max Trench Bottom Depth 36in Gravel Depth 12in

☐ New System ☒ Repair System Type: I (II) III, IV, V, VI

System Description:

Repair System Description: Gravity Conventional

Maintenance Agreement Required: ☐ Yes ☐ No

☒ House/Mod. Home No. Bedrooms 2

☐ Mobile Home No. Bathrooms 1

☐ Business No. Employees

☐ Other


☐ Slab ☒ Crawl Space ☐ Basement w/plumbing ☐ Basement wo/plumbing

Water Supply: ☒ Individual ☐ Public ☐ Community


Comments/Conditions: This Permit serves as 'Notice of Violation' Check sanitary 'T' replace if needed Install 2 lines on contour.

Comments/Conditions:

INITIAL SITE SKETCH

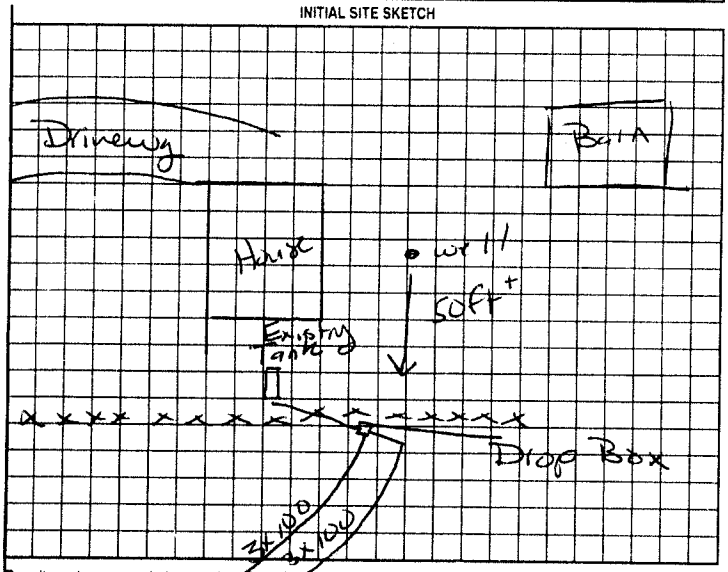


AS BUILT SKETCH

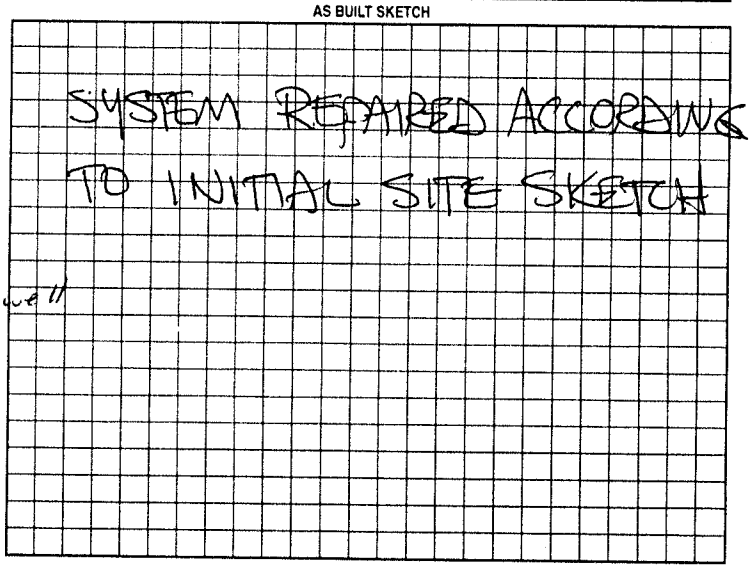


Permit can be suspended or revoked if any false information is supplied toward securing the permit/any unauthorized changes are made to the site/any unauthorized changes are made in the installation of the system. Improvement Permit with plat valid without expiration. Improvement Permit with site plan valid for sixty months. Authorization to Construct is valid for a period equal to that of Improvement Permit – not to exceed sixty months.

Signed: Dwight W Padgett date

Improvement Permit by: Mark Craft RS date 5-17-99

Authorization to Construct by: Mark Craft RS date 5-17-99

Installed by: SAMMY REAVIS

Operation Permit by: STEVE HEDRICK date 6-8-99

Existing System Inspection by: date

HEALTH DEPT COPY WHITE OWNER COPY (FINAL) YELLOW OWNER COPY (INITIAL) PINK