IREDELL COUNTY HEALTH DEPARTMENT - *ENVIRONMENTAL HEALTH* ☑ STATESVILLE OFFICE 704-878-5305 ☐ MOORESVILLE OFFICE 704-664-5281

IMPROVEMENT PERMIT / AUTHORIZATION TO CONSTRUCT / OPERATION PERMIT / EXISTING SYSTEM INSPECTION

PERMIT # 172306 PIN # 4872-23-9038 DATE JUNE 20, 2012

OWNER HOLLY SPRINGS BAPT. CH APPLICANT: SAME PHONE: Home/Cell # 704-546-2483 Business # 704-546-7575

SITE ADDRESS 355 RABBIT HIGHWAY OWNER / APPLICANT ADDRESS 355 RABBIT HWY, HARMONY, NC 28634

SITE DIRECTIONS US 21 NORTH, TL W. HOUSTONVILLE ROAD, CHURCH ON LEFT AT RABBIT HIGHWAY

SUBDIVISION NA BLOCK / SECTION NA LOT # NA LOT AREA 13.9 ACRES DESIGN FLOW 378 L.T.A.R. 0.30 GPD/FT

Septic Tank 1000 Gallons: STB 1000 Date 11-22-12 ☑ New System ☐ Repair ☐ Expansion System Type I II (III) IV V VI

GREASE TRAP 1000 Gallons: STB 1000 Date 7-10-12 System Description: 25% REDUCTION, GRAVITY

Pump Make ____ Model ____ Serial # ____ Repair System Description: 25% REDUCTION, PUMP

No. Nitrification Fields: 1 No. Lines 6 Linear Feet 315 +- Maintenance Agreement Required ☐ YES ☑ NO

Trench Width 36" Max. Trench Bottom Depth 36" Gravel Depth N/A ☑ GRAVITY ☐ PRESSURE

☐ Residence No. Bedrooms ____ Water Supply

☐ Business No. Persons 126 ☐ Private


☑ CHURCH No. Employees 3 PERS ☑ Public

☑ Slab ☐ Crawl Space ☐ Community


☐ Basement w/plumbing ☐ Basement w/o plumbing

Comments / Conditions THE GREASE TRAP SHALL BE PLUMBED TO RECEIVE ALL WASTES ASSOCIATED WITH FOOD HANDLING & NO TOILET WASTES. INSTALL 25% REDUCTION SYSTEM ON CONTOUR, NO DEEPER THAN 36" AS SHOWN.

INITIAL SITE SKETCH

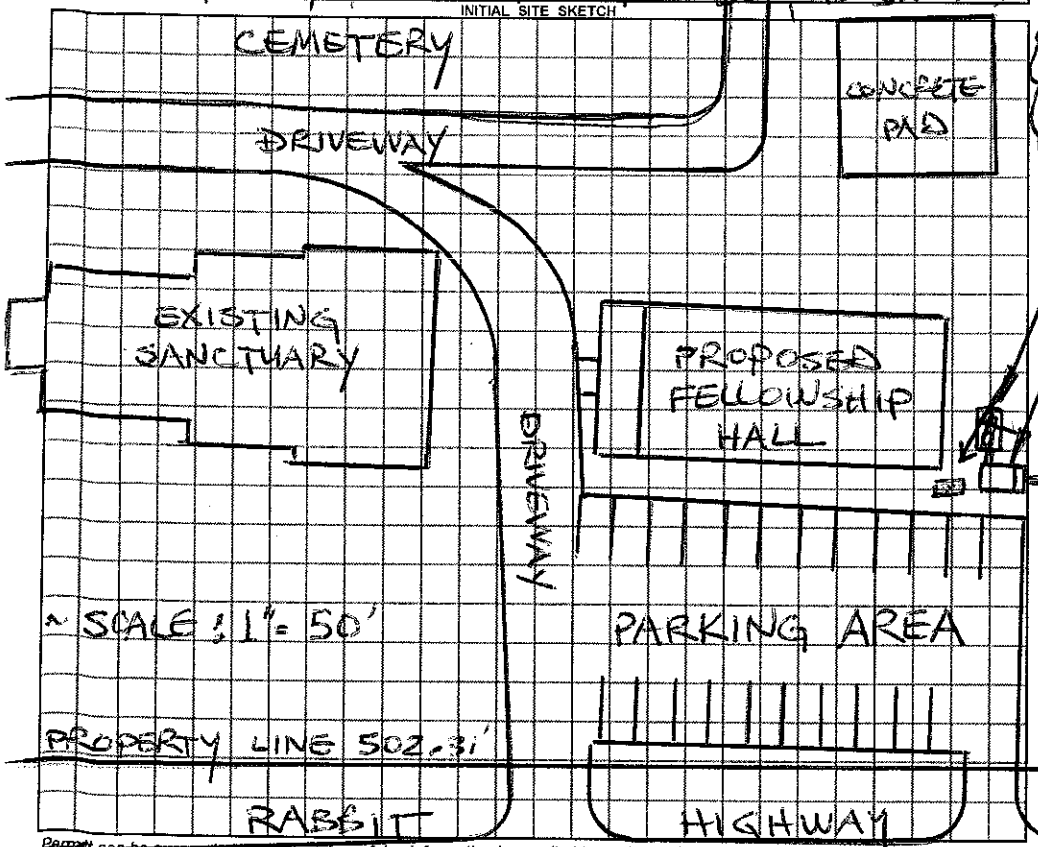

AS BUILT SKETCH

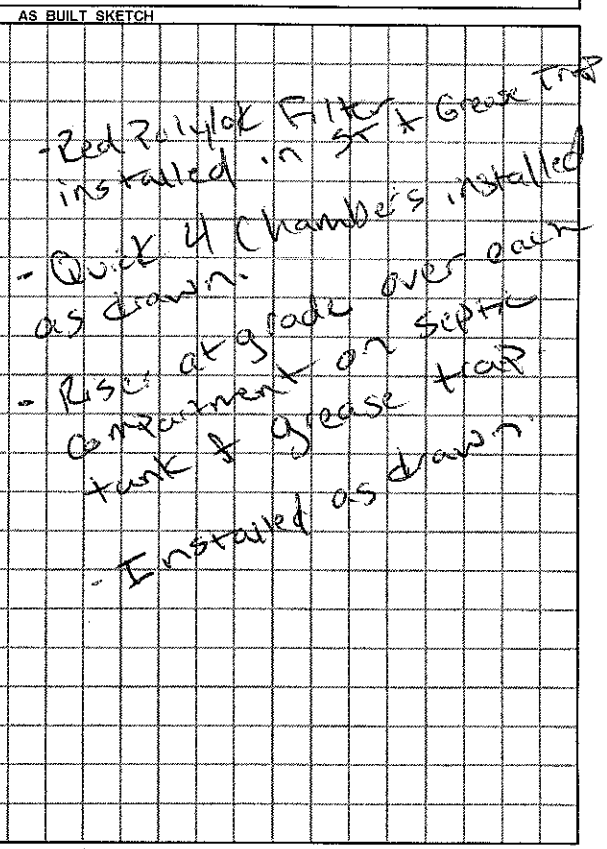

Permit can be suspended or revoked if any false information is supplied toward securing the permit / any unauthorized changes are made to the site / any unauthorized changes are made in the installation of the system.

☑ ***IMPROVEMENT PERMIT*** with plat valid without expiration. ☐ ***IMPROVEMENT PERMIT*** with ~~plat valid without expiration~~ site plan valid 60 mo. ☑ ***AUTHORIZATION TO CONSTRUCT*** valid for period equal to IMPROVEMENT PERMIT--not to exceed 60 mo.

Owner / Applicant Signature: Edward Shumaker Date 6-22-12 Installed by: Groundbreakers

IMPROVEMENT PERMIT by: STEVE HEDRICK REHS Date 6-20-12 OPERATION PERMIT by: Justin Reeder REHS Date 2-4-13

AUTHORIZATION TO CONSTRUCT by: STEVE HEDRICK REHS Date 6-20-12 Existing System Inspected by: ____ REHS Date ____

YOU SHOULD CONTACT A LOCATOR SERVICE PRIOR TO ANY EXCAVATION

White Copy – Environmental Health YELLOW COPY (Final) Owner / Applicant PINK COPY (Initial) Owner / Applicant