IREDELL COUNTY HEALTH DEPARTMENT

STATESVILLE 704-878-5305 MOORESVILLE 704-664-5281

IMPROVEMENT PERMIT / CERTIFICATE OF COMPLETION / OPERATION PERMIT / EXISTING SYSTEM INSPECTION

PROPERTY DESCRIPTION NO. 20972 DATE 5/22/95 TAX MAP NO. 17K-A-69 Watershed: ☐ Yes ☑ No ~~WS II-BW~~

OWNER OR CONTRACTOR DAVID PIGMAN PHONE: Business Home 539-5559

ADDRESS P.O. BOX 23, UNION GROVE NC 28689

LOCATION 45 21 N, TL HOUSTONVILLE RD, TR DARE RD, TL TROY MILL RD, 1ST DRIVE ON LEFT

SUBDIVISION BLOCK / SECTION LOT LOT AREA 4 ACRES± SITE CLASS. PS DESIGN FLOW 360 L.T.A.R. 0.27 GPD/FT2

Septic Tank: 1000 Gallons; STB 620 Date 6-25-98
Pump Tank: Gallons; PT Date
Pump Make: Model Serial No.
Nitrification Field: No Fields 1 Square Feet 1350 Linear Feet 450
No Lines 3 Trench Width 36" Max Trench Bottom Depth 18-36" Gravel Depth 12

☑ New System ☐ Repair System Type: I, II, III, IV, V, VI
System Description: CONVENTIONAL GRAVITY
Repair System Description: CONV. GRAVITY
Maintenance Agreement Required: ☐ Yes ☑ No

☐ House/Mod. Home No. Bedrooms 3
☑ Mobile Home No. Bathrooms 2
☐ Business No. Employees
☐ Other


☐ Slab ☑ Crawl Space ☐ Basement w/plumbing ☐ Basement wo/plumbing

Water Supply: ☑ Individual ☐ Community ☐ Public WELL


Comments: ① KEEP SYSTEM MINIMUM 5' FROM MH, 10' FROM PROPERTY LINE, 10' FROM WATER LINE, MAX. FEASIBLE DISTANCE FROM WELL, NO LESS THAN 50' ② INSTALL LINES AS SHOWN, ON CONTOUR

Comments: SYSTEM LOCATION CHANGED W/O PRIOR APPROVAL FROM H.D.; DUE TO NEW PROPERTY LINE AS SHOWN.

INITIAL SITE SKETCH

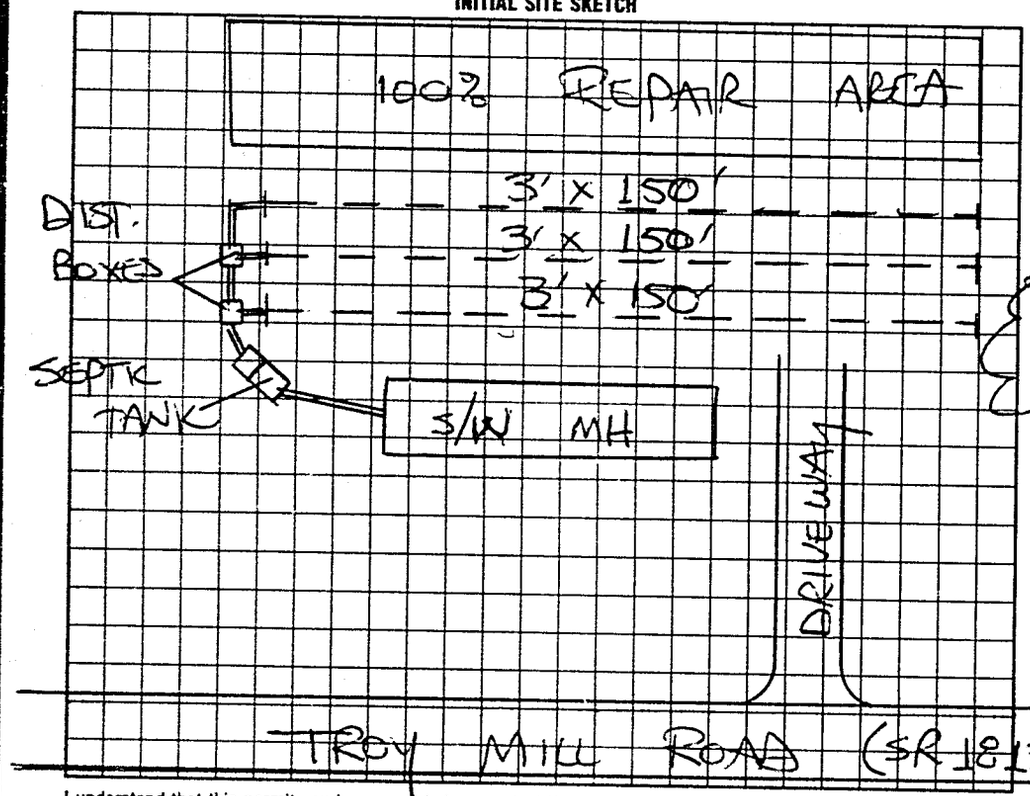

AS BUILT SKETCH

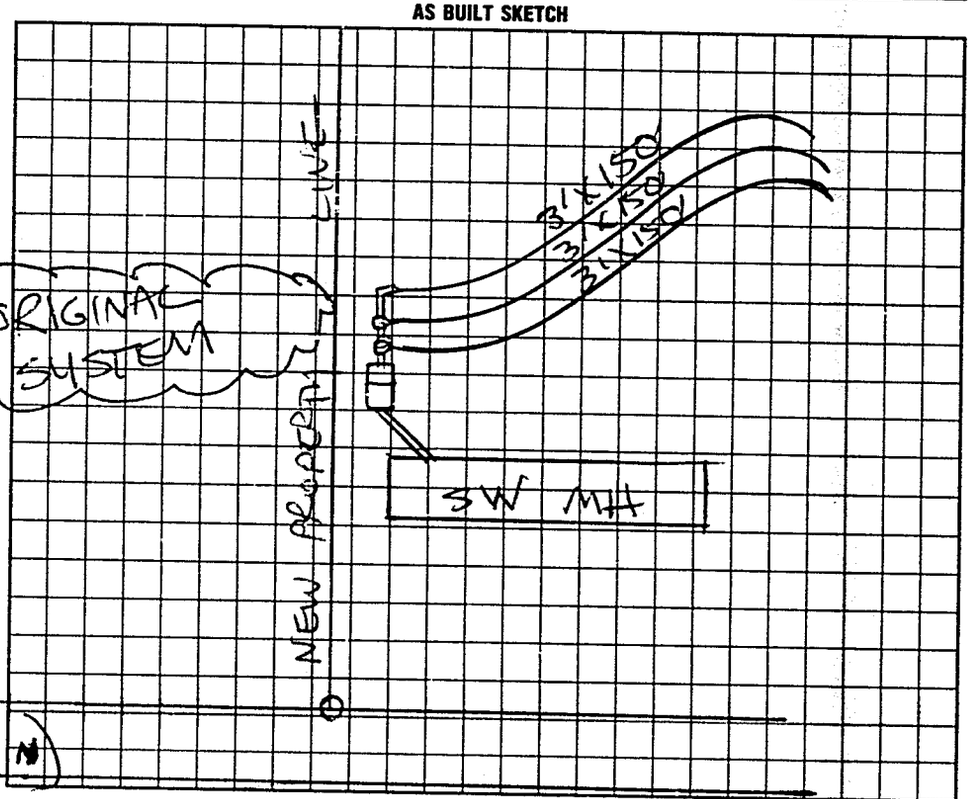

I understand that this permit can be suspended or revoked if any false information is supplied toward securing the permit/any unauthorized changes are made to the site/any unauthorized changes are made in the installation of the system. Improvement Permit is valid for 60 months from date of issuance.

Signed: X David Clayton

Improvement Permit by: STEVE HEDRICK date 5/22/95

Existing System Inspection by: date

Installed by: SAMMY REAVIS

Certificate of Completion by: STEVE HEDRICK date 11-5-98

Operation Permit by: date

HEALTH DEPT. COPY: WHITE INSPECTION COPY (FINAL): GREEN OWNER COPY (FINAL): YELLOW INSPECTION COPY (INITIAL): PINK OWNER COPY (INITIAL): GOLD