IREDELL COUNTY HEALTH DEPARTMENT

STATESVILLE 704-878-5305 MOORESVILLE 704-664-5281

IMPROVEMENT PERMIT / AUTHORIZATION TO CONSTRUCT / OPERATION PERMIT / EXISTING SYSTEM INSPECTION

PERMIT# 150088 PIN# 4817248443 DATE 6-25-08

OWNER OR APPLICANT Jody Pigman PHONE: Business _____ Home 704-873-2547

ADDRESS P.O. Box 23 Hamptonville, NC 27020

LOCATION 376 Troy Mill Rd.

SUBDIVISION n/a BLOCK / SECTION _____ LOT ~~n/a~~ 1 LOT AREA 1.11 Ac. SITE CLASS. P5 DESIGN FLOW 480 L.T.A.R. .3

Septic Tank: Ex. Gallons; STB Ex. Date Ex

Pump Tank: _____ Gallons; PT _____ Date _____

Pump Make: _____ Model _____ Serial No. _____

Nitrification Field: No Fields ___ Square Feet _____ Linear Feet 100

No Lines 1 Trench Width 36" Max Trench Bottom Depth 36" Gravel Depth _____

☐ New System ☐ Repair ☒ Expansion System Type: I (II) III IV V VI

System Description: Conventional-Initial / 25% Exp.

Repair System Description: 25% Gravity

Maintenance Agreement Required: ☐ Yes ☒ No

☒ Gravity ☐ Pressure

☒ House/Mod. Home ☐ Mobile Home ☐ Business ☐ Other

No. Bedrooms 4 No. Persons ___ No. Employees ___

Water Supply: ☒ Individual ☐ Public ☐ Community


☐ Slab ☒ Crawl Space ☐ Basement w/plumbing ☐ Basement wo/plumbing

Comments/Conditions:

1" = 50'

Comments/Conditions:

INITIAL SITE SKETCH

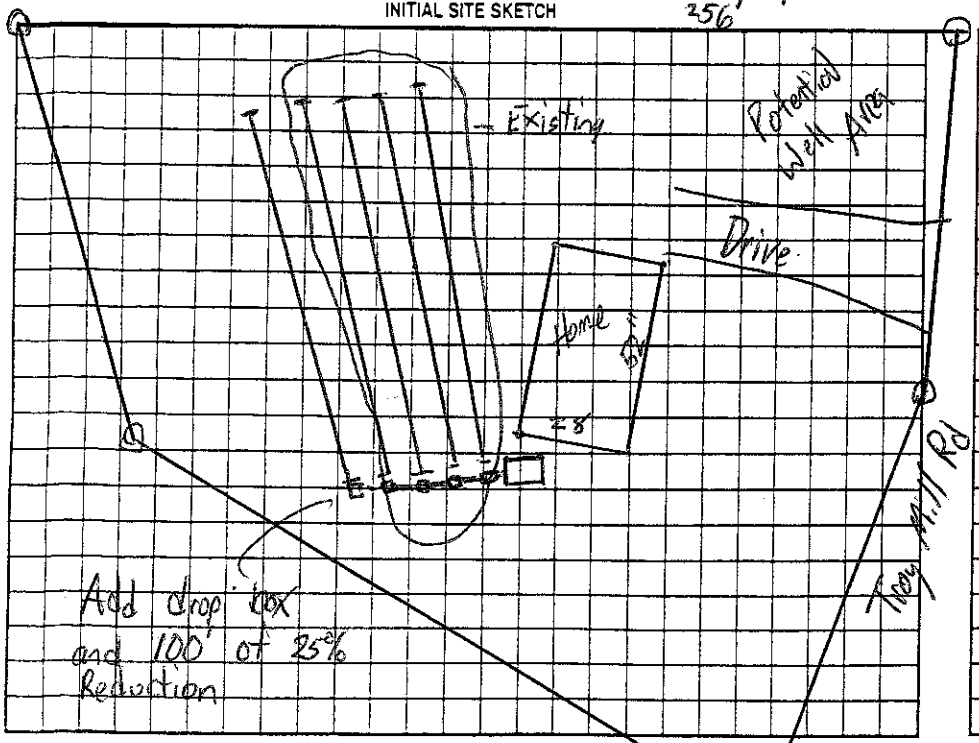

AS BUILT SKETCH

Permit can be suspended or revoked if any false information is supplied toward securing the permit/any unauthorized changes are made to the site/any unauthorized changes are made in the installation of the system. Improvement Permit with plat valid without expiration ☐ Improvement Permit with site plan valid for sixty months ☒ Authorization to Construct is valid for a period equal to that of Improvement Permit – not to exceed sixty months.

Signed: _____ date 6-27-08 Installed by: A-1 Backhoe

Improvement Permit by: _____ date 6-25-08 Operation Permit by: _____ date 7-1-08

Authorization to Construct by: _____ date 6-25-08 Existing System Inspection by: _____ date _____

HEALTH DEPT. COPY: WHITE OWNER COPY (FINAL): YELLOW OWNER COPY (INITIAL): PINK