IREDELL COUNTY HEALTH DEPARTMENT

STATESVILLE 704-878-5305 MOORESVILLE 704-664-5281

IMPROVEMENT PERMIT / AUTHORIZATION TO CONSTRUCT / OPERATION PERMIT / EXISTING SYSTEM INSPECTION

PERMIT# 15008 PIN# 4872588443 DATE 6-4-08

OWNER OR APPLICANT Jody Pierson PHONE: Business _____ Home 704-873 2547

ADDRESS Box 23 Harmony NC 28634

LOCATION 77N (R) 901 (L) Eagle Mill (R) Troutmill - on right left down RD

SUBDIVISION _____ BLOCK / SECTION _____ LOT _____ LOT AREA 1.441 SITE CLASS. B DESIGN FLOW 360 L.T.A.R. .3

Septic Tank: NDO Gallons: STB 1250 Date 6-2-98

Pump Tank: _____ Gallons; PT _____ Date _____

Pump Make: _____ Model _____ Serial No. _____

Nitrification Field: No Fields ____ Square Feet _____ Linear Feet _____

No Lines _____ Trench Width _____ Max Trench Bottom Depth _____ Gravel Depth _____

☐ ~~New System~~ ☐ Repair ☐ Expansion System Type: I II III IV V VI

System Description: Conv. Gravity

Repair System Description: 2540 Gravity

Maintenance Agreement Required: ☐ Yes ☐ No

☐ Gravity ☐ Pressure

☐ House/Mod. Home No. Bedrooms 3

☐ Mobile Home No. Persons ____

☐ Business No. Employees ____

☐ Other _____


Water Supply: ☐ Individual ☐ Public ☐ Community

☐ Slab ☐ Crawl Space ☐ Basement w/plumbing ☐ Basement wo/plumbing


Comments:/Conditions: Mobile Home to be in exact location as other.

Comments:/Conditions:

INITIAL SITE SKETCH

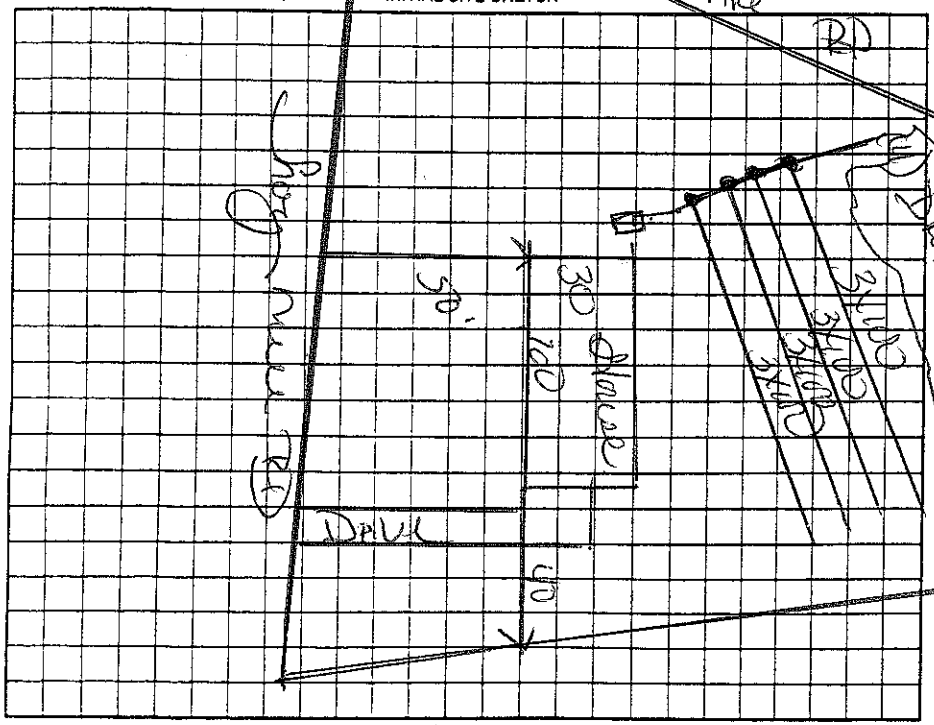

AS BUILT SKETCH

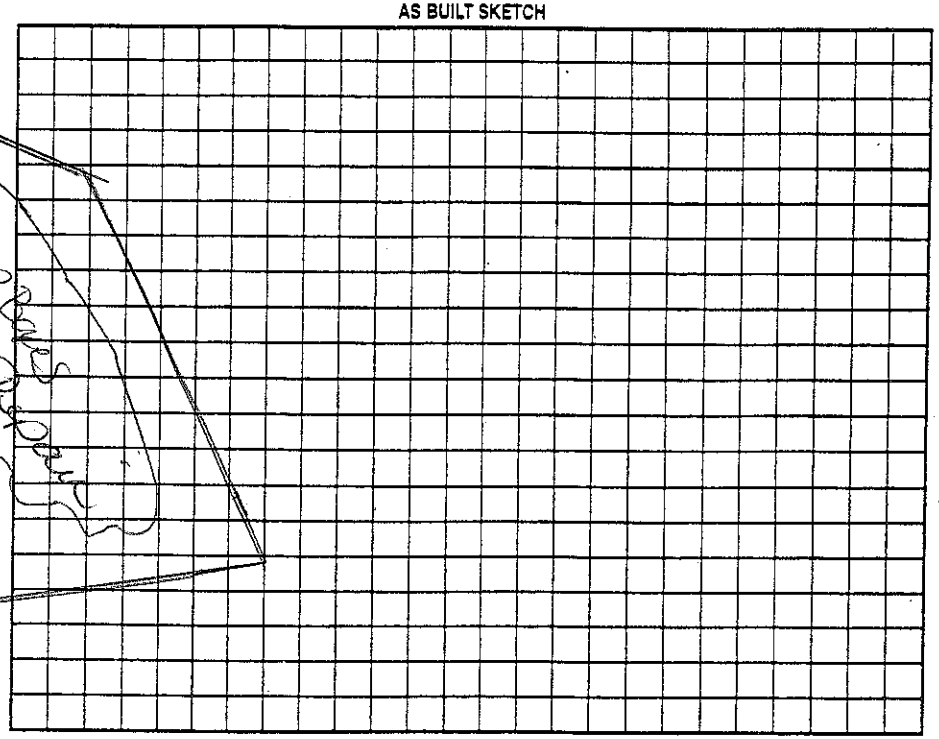

Permit can be suspended or revoked if any false information is supplied toward securing the permit/any unauthorized changes are made to the site/any unauthorized changes are made in the installation of the system. Improvement Permit with plat valid without expiration ☐ Improvement Permit with site plan valid for sixty months ☑ Authorization to Construct is valid for a period equal to that of Improvement Permit – not to exceed sixty months.

Signed: _____ date 6-4-08 Installed by: _____

Improvement Permit by: _____ date _____ Operation Permit by: _____ date _____

Authorization to Construct by: _____ date _____ Existing System Inspection by: _____ date 6-4-08

HEALTH DEPT. COPY: WHITE OWNER COPY (FINAL): YELLOW OWNER COPY (INITIAL): PINK