1:30 Ricky Scott Campbell

IREDELL COUNTY HEALTH DEPARTMENT

STATESVILLE 704-878-5305 CT MOORESVILLE 704-664-5281

IMPROVEMENT PERMIT / AUTHORIZATION TO CONSTRUCT / OPERATION PERMIT / EXISTING SYSTEM INSPECTION

PERMIT# 146097 PIN# 4872-43-0816 DATE 11-6-07

OWNER OR APPLICANT FREEDOM HOMES - STATESVILLE #664 PHONE: Business 704-872-0179 Home

ADDRESS 1270 NORTHSIDE DRIVE, STATESVILLE, NC 28677

LOCATION US 21 North, TL Houstonville Road, on Right, just past Dare Road

SUBDIVISION BLOCK / SECTION LOT LOT AREA 0.786 ACRE SITE CLASS. PS DESIGN FLOW 240 L.T.A.R. 0.30 GAD/FT²

Septic Tank: 1000 Gallons; STB 794 Date 2-22-07
Pump Tank: Gallons; PT Date
Pump Make: Model Serial No.
Nitrification Field: No Fields 1 Square Feet ea. to 800 Linear Feet 200
No Lines TWO Trench Width 36" Max Trench Bottom Depth 36

☑ New System ☐ Repair ☐ Expansion System Type: I II III IV V VI
System Description: 25% REDUCTION SYSTEM
Repair System Description: 25% REDUCTION, GRAVITY
Maintenance Agreement Required: ☐ Yes ☑ No

☑ House/Mod. Home No. Bedrooms 1
☐ Mobile Home No. Persons
☐ Business No. Employees
☐ Other


Water Supply: ☑ Individual ☐ Public ☐ Community WELL

Gravel Depth N/A ☑ Gravity ☐ Pressure ☐ Slab ☑ Crawl Space ☐ Basement w/plumbing ☐ Basement wo/plumbing


Comments:/Conditions: INSTALL 25% REDUCTION SYSTEM ON CONTOUR AS FLAGGED

Comments:/Conditions:

INITIAL SITE SKETCH

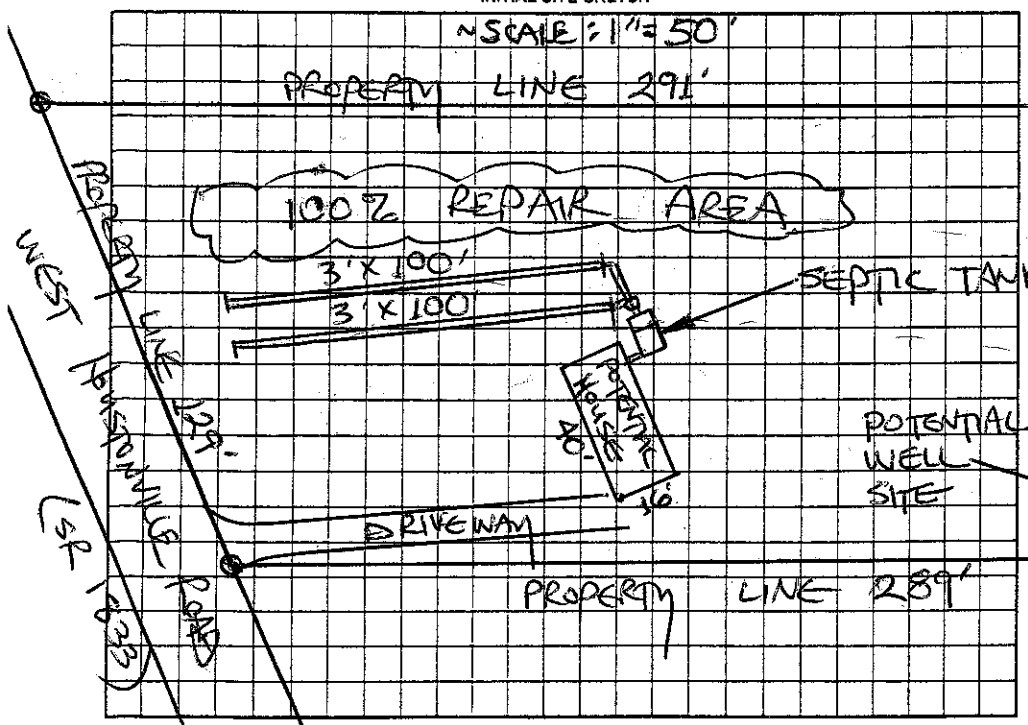

AS BUILT SKETCH

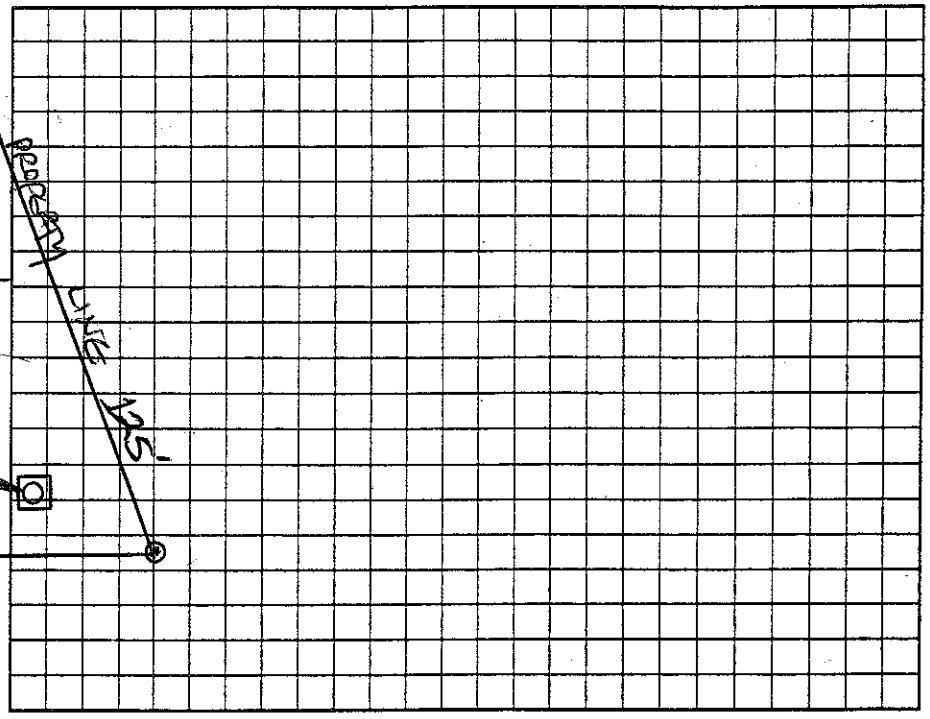

Permit can be suspended or revoked if any false information is supplied toward securing the permit/any unauthorized changes are made to the site/any unauthorized changes are made in the installation of the system. Improvement Permit with plat valid without expiration. ☐ Improvement Permit with site plan valid for sixty months ☑ Authorization to Construct is valid for a period equal to that of Improvement Permit – not to exceed sixty months.

Signed: date 11-6-07 Installed by: Scott Campbell / Wastewater Solutions

Improvement Permit by: STEVE HEDRICK date 11-6-07 Operation Permit by: James Clark date 12-7-07

Authorization to Construct by: STEVE HEDRICK date 11-6-07 Existing System Inspection by: date

HEALTH DEPT. COPY: WHITE OWNER COPY (FINAL): YELLOW OWNER COPY (INITIAL): PINK