IREDELL COUNTY HEALTH DEPARTMENT

[redacted]le Phone TR 3-7271 Mooresville Phone No. 664-5281

PERMIT TO INSTALL SEPTIC TANK

Permit No. _____ Permit Date 6-5 1973

Owner Mt. Carmel Holiness Church Address R.1 Hamptonville

Installed By Lawrence Pearson Address Statesville,


Location of Property 21 N Past Harmony - T.L. At Mayberry's Store in Hamptonville - Go 1/4 Mile - Church on Right.

Tank		Capacity		Length of Lines		Fixtures	
Block	( )	1000	(✓)	225'	(✓)	No. of Baths	(2)
Precast	(✓)	1250	( )	250'	( )	Dishwasher	( )
		1500	( )	Other_____		Garbage Grdr.	( )
		Other_____				Other_____	

NOTIFY HEALTH DEPARTMENT AT LEAST EIGHT HOURS BEFORE TANK IS TO BE INSPECTED.

Final Inspection 6-5 1973 Approved (✓) Disapproved ( )

Remarks _____

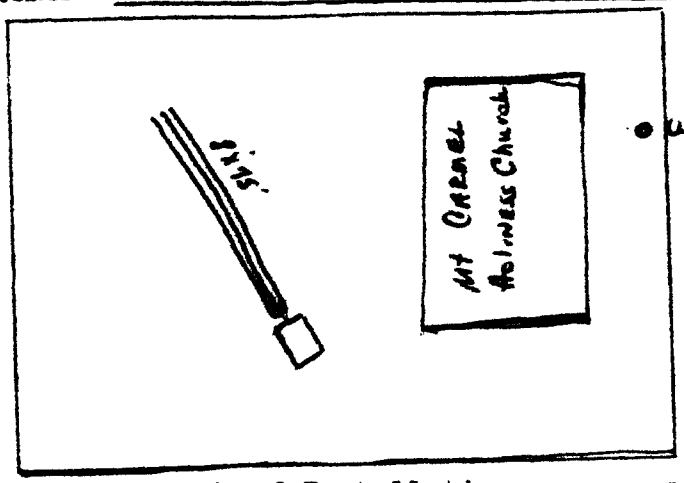

Sketch of Installation

Sanitarian