IREDELL COUNTY HEALTH DEPARTMENT

STATESVILLE 704-878-5305 MOORESVILLE 704-664-5281

IMPROVEMENT PERMIT / AUTHORIZATION TO CONSTRUCT / OPERATION PERMIT / EXISTING SYSTEM INSPECTION

PERMIT# 075786 PIN# 4872 74 4677 & 4872 74 2354 DATE 8-31-98

OWNER OR CONTRACTOR ROYSTER CLARK PHONE: Business 546-2384 Home

ADDRESS 4191 HARMONY HIGHWAY, HARMONY, NC 28634

LOCATION US 21 NORTH, ON LEFT AT HOUSTONVILLE ROAD

SUBDIVISION BLOCK / SECTION LOT LOT AREA 80.0 ACRES SITE CLASS. PS DESIGN FLOW 100 L.T.A.R. 0.30 GPD/FT²

Septic Tank: 1000 Gallons; STB 620 Date 8-26-98

Pump Tank: 1000 Gallons; PT 144 Date

Pump Make: ZOELLER Model M97-C Serial No.

Nitrification Field: No Fields 1 Square Feet 360 Linear Feet 120

No Lines TWO Trench Width 36" Max Trench Bottom Depth 36" Gravel Depth 12"

☒ New System ☐ Repair System Type: I, II, (III), IV, V, VI

System Description: CONVENTIONAL PUMP

Repair System Description: CONV. PUMP

Maintenance Agreement Required: ☐ Yes ☒ No

☐ House/Mod. Home No. Bedrooms

☐ Mobile Home No. Bathrooms

☒ Business No. Employees 4

☐ Other (2) 25 GPD/EMPLOYEE


☐ Slab ☒ Crawl Space ☐ Basement w/plumbing ☐ Basement wo/plumbing

Water Supply: ☒ Individual ☐ Public ☐ Community WELL


Comments/Conditions: (1) SEE ATTACHED EASEMENT FOR SEPTIC DRAINFIELD (2) SEE ATTACHED SHEETS FOR PUMP AND PRESSURE MANIFOLD REQUIREMENTS (3) CONSTRUCT SUBSURFACE DRAINAGE DITCH BEGINNING 48" DEEP,

Comments/Conditions: LINES & TANKS CHECKED 10-5-98
SUBSURFACE INTERCEPT DRAINAGE DITCH CHECKED 10-6-98

INITIAL SITE SKETCH

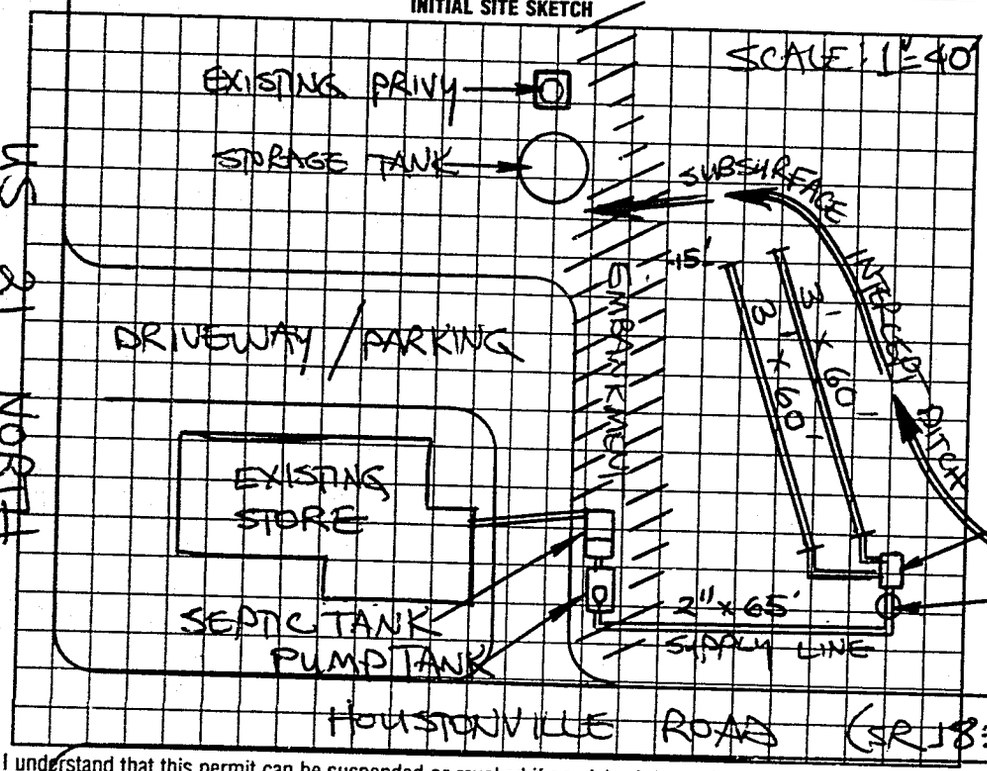

AS BUILT SKETCH

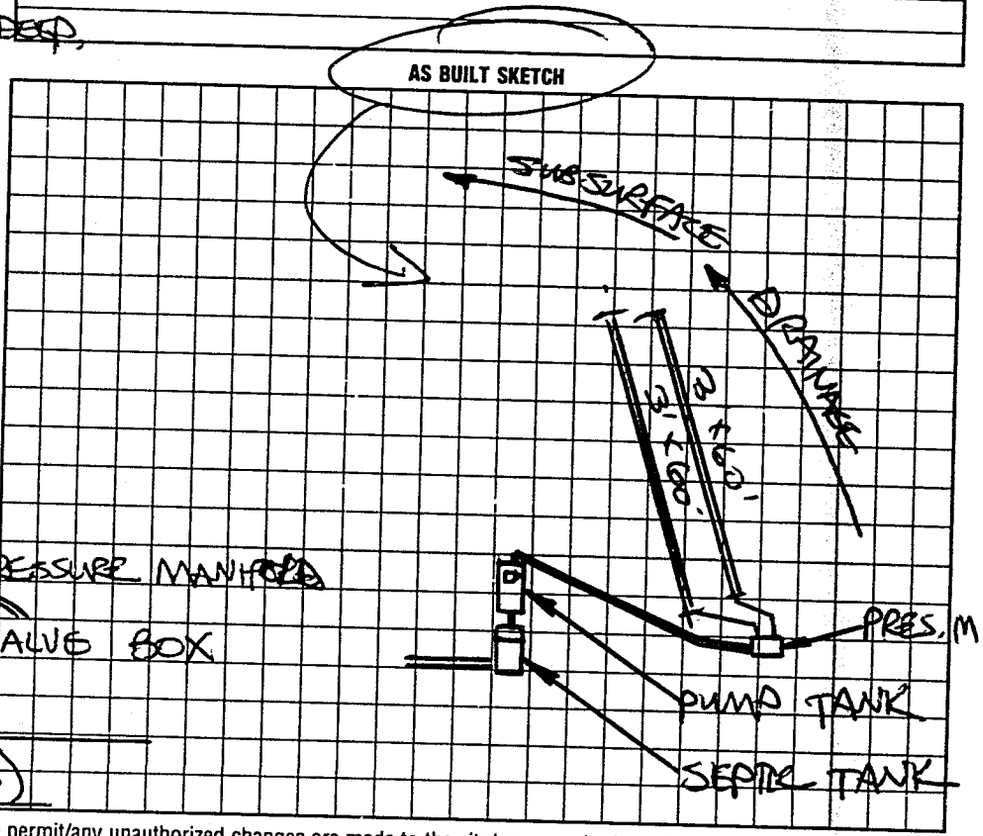

I understand that this permit can be suspended or revoked if any false information is supplied toward securing the permit/any unauthorized changes are made to the site/any unauthorized changes are made in the installation of the system. Improvement Permit with plat valid without expiration. Improvement Permit with site plan valid for sixty months. Authorization to Construct is valid for a period equal to that of Improvement Permit – not to exceed sixty months.

Signed: Bob Nicholson date 8-31-98

Improvement Permit by: STEVE HEDRICK date 8-31-98

Authorization to Construct by: STEVE HEDRICK date 8-31-98

Installed by: SAMMY REAVIS

Operation Permit by: STEVE HEDRICK date 12-29-98

Existing System Inspection by: date

HEALTH DEPT. COPY: WHITE INSPECTION COPY (FINAL): GREEN OWNER COPY (FINAL): YELLOW INSPECTION COPY (INITIAL): PINK OWNER COPY (INITIAL): GOLD