IREDELL COUNTY HEALTH DEPARTMENT

STATESVILLE 704-878-5305 MOORESVILLE 704-664-5281

IMPROVEMENT PERMIT / AUTHORIZATION TO CONSTRUCT / OPERATION PERMIT / EXISTING SYSTEM INSPECTION

PERMIT# 078916 PIN# 4873 14 4424 (PART) DATE 2-23-99

OWNER OR CONTRACTOR CHRISTOPHER REAVIS PHONE: Business Home 539-4346

ADDRESS 693 TROY MILL ROAD, HAMPTONVILLE NC 27020

LOCATION I-77 N, TR NC901, TL EAGLE MILLS RD, TR TROY MILL ROAD, ON LEFT ACROSS FROM BOX #693

SUBDIVISION BLOCK / SECTION LOT LOT AREA 1.43 ACRES SITE CLASS PS DESIGN FLOW 360 L.T.A.R. 0.40 GPD/FT²

Septic Tank: 1000 Gallons; STB 1012 Date 1-5-99

Pump Tank: Gallons; PT Date

Pump Make: Model Serial No.

Nitrification Field: No Fields 1 Square Feet 900 Linear Feet 300

No Lines FIVE Trench Width 36" Max Trench Bottom Depth 36" Gravel Depth 12"

☑ New System ☐ Repair System Type: I II III IV V VI

System Description: CONVENTIONAL GRAVITY

Repair System Description: CONVENTIONAL PUMP

Maintenance Agreement Required: Yes ☑ No

☑ House/Mod. Home No. Bedrooms 3

☑ Mobile Home No. Bathrooms 2

☐ Business No. Employees

☐ Other

☐ Slab ☑ Crawl Space ☐ Basement w/plumbing ☐ Basement wo/plumbing


Water Supply: ☑ Individual ☐ Public ☐ Community

WELL

Comments/Conditions:

Comments/Conditions SEPTIC TANK WITH RISERS INSTALLED WITH "POLYLOK" FILTER

INITIAL SITE SKETCH

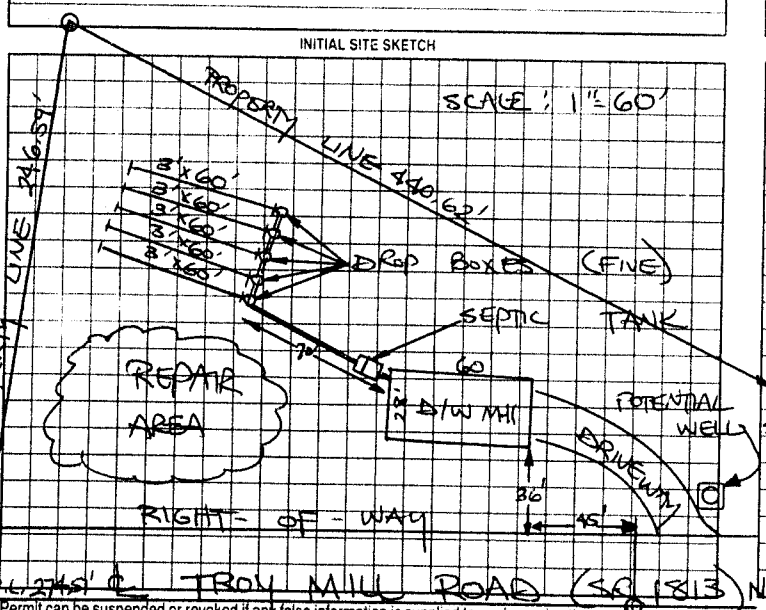

AS BUILT SKETCH

SYSTEM INSTALLED ACCORDING TO INITIAL SITE SKETCH

Permit can be suspended or revoked if any false information is supplied toward securing the permit, any unauthorized changes are made to the site, any unauthorized changes are made in the installation of the system. Improvement Permit with plat valid without expiration. Improvement Permit with site plan valid for sixty months. Authorization to Construct is valid for a period equal to that of Improvement Permit – not to exceed sixty months.

Signed: Chris Reavis date 2-23-99

Improvement Permit by: STEVE HEDRICK date 2-23-99

Authorization to Construct by: STEVE HEDRICK date 2-23-99

Installed by: A-1 BACKHOE

Operation Permit by: STEVE HEDRICK date 3-11-99

Existing System Inspection by: date

HEALTH DEPT COPY WHITE OWNER COPY (FINAL) YELLOW OWNER COPY (INITIAL) PINK