IREDELL COUNTY HEALTH DEPARTMENT

STATESVILLE 704-878-5305 MOORESVILLE 704-664-5281

IMPROVEMENT PERMIT / AUTHORIZATION TO CONSTRUCT / OPERATION PERMIT / EXISTING SYSTEM INSPECTION

PERMIT# 079455 PIN# 4873 32 6185 (PT) DATE 2-26-99

OWNER OR CONTRACTOR TERRY RENEGAR PHONE: Business Home 546-5380

ADDRESS 145 ELEANOR LANE, HAMPTONVILLE, NC 27020

LOCATION US 21 N, TL HUNTING CREEK RD, ON LEFT ACROSS FROM DASH ROAD

SUBDIVISION BLOCK / SECTION LOT LOT AREA 3.00 ACS SITE CLASS. PS DESIGN FLOW 360 L.T.A.R. 0.30 GPD/FT

Septic Tank: 1000 Gallons; STB 620 Date 2-23-99
Pump Tank: Gallons; PT Date
Pump Make: Model Serial No.
Nitrification Field: No Fields 1 Square Feet 1200 Linear Feet 400
No Lines THREE Trench Width 36" Max Trench Bottom Depth 36" Gravel Depth 12"

✓ New System Repair System Type: I II III IV V VI
System Description: CONVENTIONAL GRAVITY
Repair System Description: CONV. GRAVITY
Maintenance Agreement Required: Yes ✓ No


✓ House/Mod. Home No. Bedrooms 3
✓ Mobile Home No Bathrooms 2
Business No Employees
Other
Slab ✓ Crawl Space Basement w/plumbing Basement w/o/plumbing

Water Supply:
✓ Individual
Public
Community
WELL

Comments/Conditions:


POTENTIAL WELL SITE

INITIAL SITE SKETCH SCALE: 1" = 50'

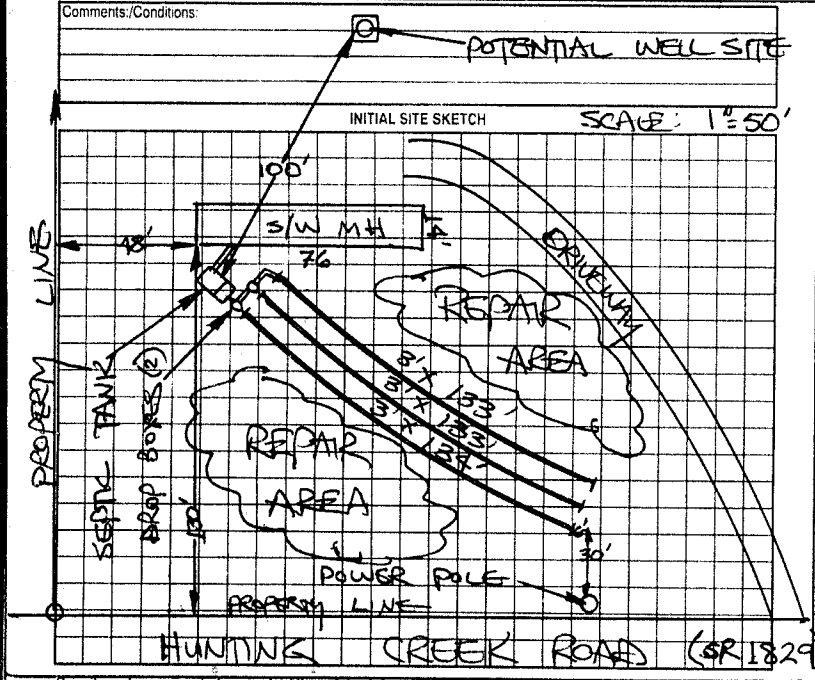

Comments/Conditions:

AS BUILT SKETCH

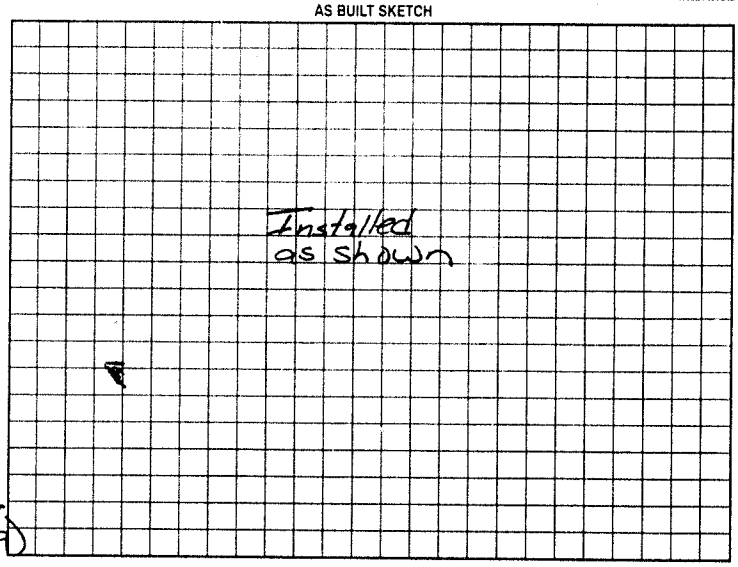

Permit can be suspended or revoked if any false information is supplied toward securing the permit/any unauthorized changes are made to the site/any unauthorized changes are made in the installation of the system. Improvement Permit with plat valid without expiration. Improvement Permit with site plan valid for sixty months. Authorization to Construct is valid for a period equal to that of Improvement Permit – not to exceed sixty months.

Signed: + Terry Renegar date 2-26-99 Installed by: Sammy Reavis

Improvement Permit by: STEVE HEDRICK date 2-26-99 Operation Permit by: Mary C. O'J PS date 4-9-99

Authorization to Construct by: STEVE HEDRICK date 2-26-99 Existing System Inspection by: date

HEALTH DEPT. COPY (WHITE) OWNER COPY (FINAL) YELLOW OWNER COPY (INITIAL) PINK