# IREDELL COUNTY HEALTH DEPARTMENT

Statesville Office (704) 878-5305 | Mooresville Office (704) 660-3625 | PERMIT # 210742

## IMPROVEMENT PERMIT / AUTHORIZATION TO CONSTRUCT / OPERATION PERMIT / EXISTING SYSTEM

PIN # 4873425032

APPLICANT: Bobbie Speaks | APPLICANT ADDRESS: 357 Hunting Creek Rd Hamptonville NC

SITE ADDRESS: 357 Hunting Creek Rd Hamptonville NC | PHONE: 704-539-4408 | ALT. PHONE: 704-682-0671

SITE DIRECTIONS: Hwy 21 N Cross Hunting creek bridge First dirt road on left First brick house on left


SUBDIVISION: N/A | SECTION: N/A | LOT # N/A | LOT AREA: 14.5ac | DESIGN FLOW: 360 | L.T.A.R.: 0.3

| | | | | | | | | | |
|---|---|---|---|---|---|---|---|---|---|
| Septic Tank | 1000 (gal) | STB | 1012-1000 | Date | 6-9-14 | ☐ New System ☒ Repair ☐ Expansion | System Type: I II ☒ III IV V VI | ☒ Residence | No. Bedrooms 3 |
| Pump Tank | (gal) | PT | | Date | | System Description: | 25% reduction | ☐ Business | No. Persons 6 |
| Pump Make | | Model | | Serial # | | Repair System Description: | | ☐ Other | No. Employees |
| # Nitrification Fields | 1 | # Lines | 3 | Linear Ft: | 300 | Maintenance Agreement Required: | ☐ YES ☒ NO | ☐ Slab | ☐ Crawl Space |
| Trench Width | 36" | Max. Trench Bottom Depth | 36" | Gravel Depth | N/A | | ☒ GRAVITY ☐ PRESSURE | ☒ Basement w/plumbing | ☐ Basement w/o plumbing |


Water Supply: ☒ Private ☐ Public ☐ Community

Comments / Conditions: Install 25% reduction on contour with Serial distribution.

INITIAL SITE SKETCH

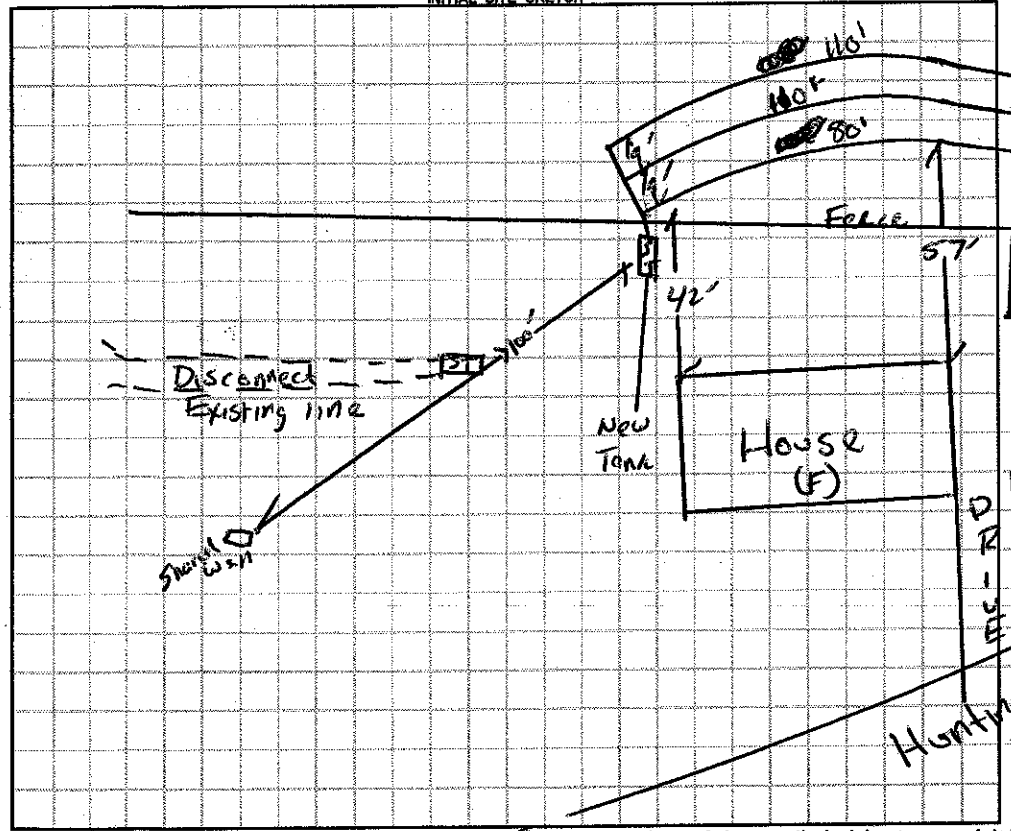


AS BUILT SKETCH

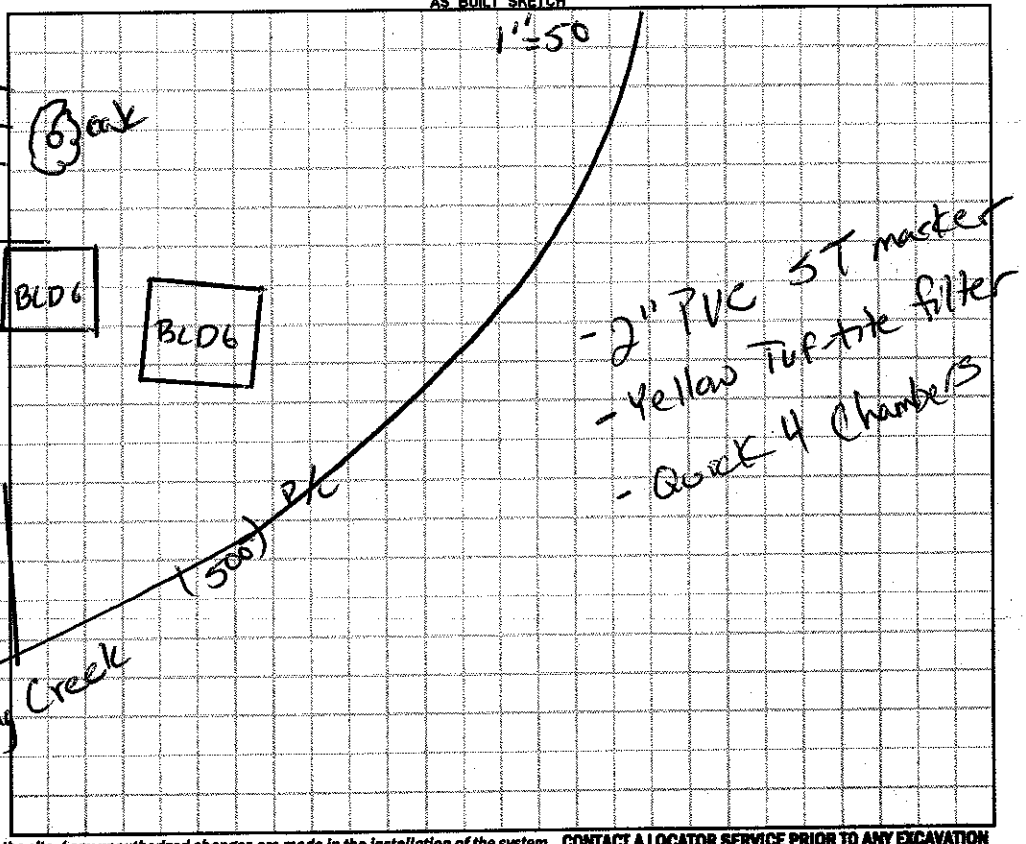


*Permit can be suspended or revoked if any false information is supplied toward securing the permit / any unauthorized changes are made to the site / any unauthorized changes are made in the installation of the system.* **CONTACT A LOCATOR SERVICE PRIOR TO ANY EXCAVATION**

☐ **IMPROVEMENT PERMIT** *with plan valid without expiration.* ☒ **IMPROVEMENT PERMIT** *with site plan valid for 60 mos.* ☒ **AUTHORIZATION TO CONSTRUCT** *valid for period equal to IMPROVEMENT PERMIT--not to exceed 60 mo.*

Owner / Applicant Signature: Bobbie Speaks Date: 5-26-15 Installed by: Tommy Frye

IMPROVEMENT PERMIT by: Debbie Ahn Date: 05/26/15 OPERATION PERMIT by: Justin Henderson Date: 5-26-15

AUTHORIZATION TO CONSTRUCT by: Debbie Ahn Date: 05/26/15 Existing System Inspected by: Date:

Health Dept. Copy - WHITE Applicant (Final Approval) - YELLOW Applicant (Conditional Approval) - PINK