PERMIT #: 207510
Bobbie Jo Speaks

Location of the proposed 28'X28' Garage addition does not appear to impact the existing on-site septic system or well.**NOTE:
Jeff Henderson REHS Date: 12-17-19
ICHD-Environmental Health Division

IREDELL COUNTY HEALTH DEPARTMENT

STATESVILLE 704-878-5305 MOORESVILLE 704-664-5281

IMPROVEMENT PERMIT / AUTHORIZATION TO CONSTRUCT / OPERATION PERMIT / EXISTING SYSTEM INSPECTION

PERMIT# 103009 PIN# 4873-42-6004 DATE 11-2-01

OWNER OR CONTRACTOR BOBBY JOE RENEGAR PHONE: Business Home (704) 539-4408

ADDRESS P.O. Box 171 HARMONY NC 28634

LOCATION US 21 N, TL HUNTING CREEK ROAD, ~ 1.5 MILE ON LEFT

SUBDIVISION BLOCK / SECTION LOT LOT AREA 15.5 ACRES SITE CLASS RS DESIGN FLOW 360 L.T.A.R. 0.40 GPD/FT²

Septic Tank: 1000 Gallons: STB 1012 Date 8.27-01
Pump Tank: Gallons: PT Date
Pump Make: Model Serial No.
Nitrification Field: No Fields 1 Square Feet 900 Linear Feet 300
No Lines THREE Trench Width 36" Max Trench Bottom Depth 30" Gravel Depth 12"

☑ New System ☐ Repair System Type: I II III IV V VI
System Description: CONVENTIONAL, GRAVITY
Repair System Description: CONV. GRAVITY
Maintenance Agreement Required: ☐ Yes ☑ No

☐ House/Mod. Home No. Bedrooms 3
☑ Mobile Home No. Bathrooms 2
☐ Business No. Employees
☐ Other
☐ Slab ☑ Crawl Space ☐ Basement w/plumbing ☐ Basement wo/plumbing


Water Supply: ☑ Individual ☐ Public ☐ Community WELL

Comments/Conditions: KEEP SYSTEM MINIMUM 100' FROM WELL


Comments/Conditions SEPTIC TANK WITH MARKER INSTALLED USING "POLY LOK" FILTER

~SCALE: 1"=50'

INITIAL SITE SKETCH

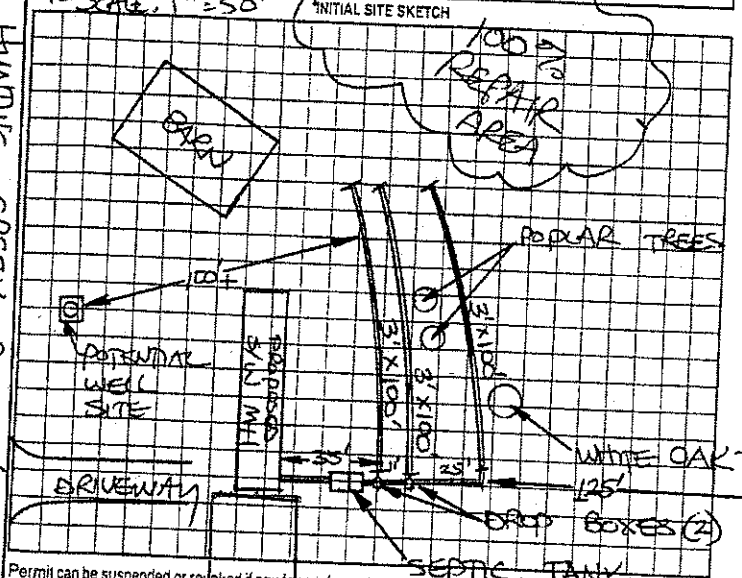

AS BUILT SKETCH

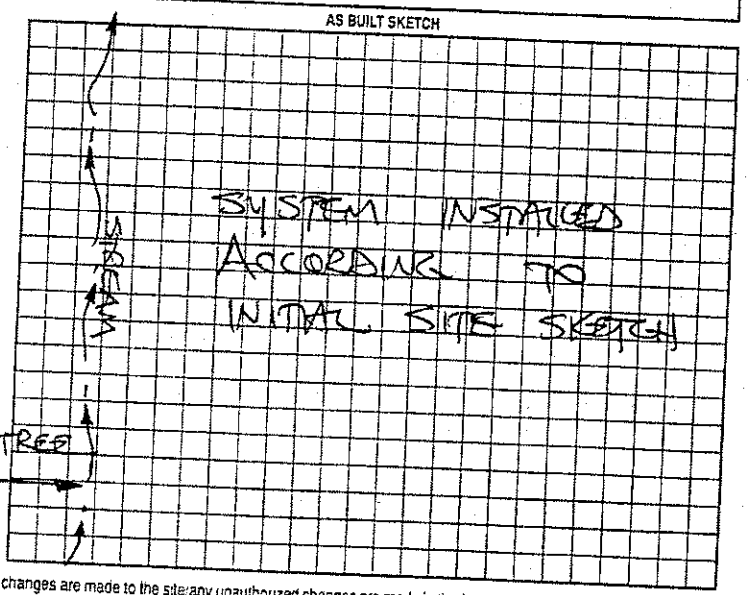

Permit can be suspended or revoked if any false information is supplied toward securing the permit/any unauthorized changes are made to the site/any unauthorized changes are made in the installation of the system. Improvement Permit with plat valid without expiration. Improvement Permit with site plan valid for sixty months. Authorization to Construct is valid for a period equal to that of Improvement Permit - not to exceed sixty months.

Signed: ± Earl Renegar date 11-2-01

Improvement Permit by: STEVE HENDRICK date 11.2.01

Authorization to Construct by: STEVE HENDRICK date 11.2.01

Installed by: MITCHELL GRADING

Operation Permit by: STEVE HENDRICK date 11-7-01

Existing System Inspection by: date

HEALTH DEPT. COPY: WHITE OWNER COPY (FINAL): YELLOW OWNER COPY (INITIAL): PINK

HUNTING CREEK ROAD (SR 1829)

28'X28' Garage