IREDELL COUNTY HEALTH DEPARTMENT

STATESVILLE 704-878-5305 MOORESVILLE 704-664-5281

IMPROVEMENT PERMIT / AUTHORIZATION TO CONSTRUCT / OPERATION PERMIT / EXISTING SYSTEM INSPECTION

PERMIT# Repair PIN# 4873-82-1107 DATE 11-19-07

OWNER OR APPLICANT Allen Dent Johnson PHONE: Business _____ Home 704-546-7594

ADDRESS 4563 Hwy 21

LOCATION US 21 North, Cross Hunting Creek. First House on left

SUBDIVISION n/a BLOCK / SECTION _____ LOT _____ LOT AREA 196.92 Ac SITE CLASS. B5 DESIGN FLOW 480 L.T.A.R. .4

Septic Tank: Existing Gallons: STB _____ Date _____

Pump Tank: _____ Gallons: PT _____ Date _____

Pump Make: _____ Model _____ Serial No. _____

Nitrification Field: No Fields 1 Square Feet 1600 Linear Feet 400

No Lines 3 or 4 Trench Width 36" Max Trench Bottom Depth 36"

☐ New System ☒ Repair ☐ Expansion System Type: I II III IV V VI

System Description: Conventional Gravity

Repair System Description: Conventional Gravity

Maintenance Agreement Required: ☐ Yes ☒ No

Gravel Depth 12" ☒ Gravity ☐ Pressure

☒ House/Mod. Home No. Bedrooms 4

☐ Mobile Home No. Persons _____

☐ Business No. Employees _____

☐ Other _____

Water Supply: ☒ Individual ☐ Public ☐ Community


☐ Slab ☐ Crawl Space ☐ Basement w/plumbing ☒ Basement wo/plumbing

Comments/Conditions:


Replace tank if necessary

Comments/Conditions:

INITIAL SITE SKETCH

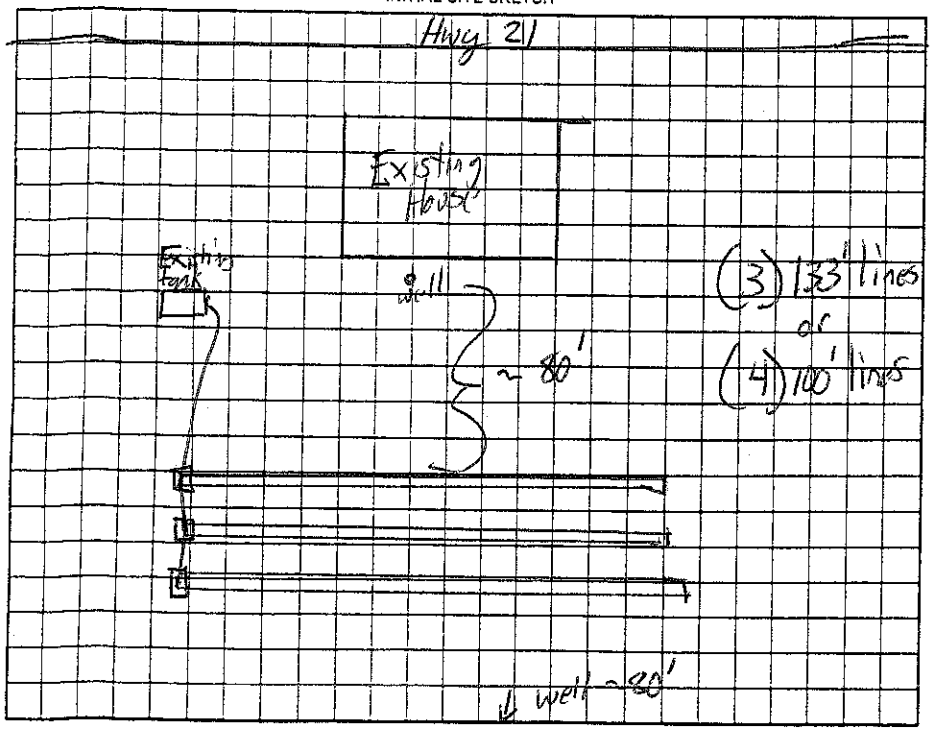

AS BUILT SKETCH

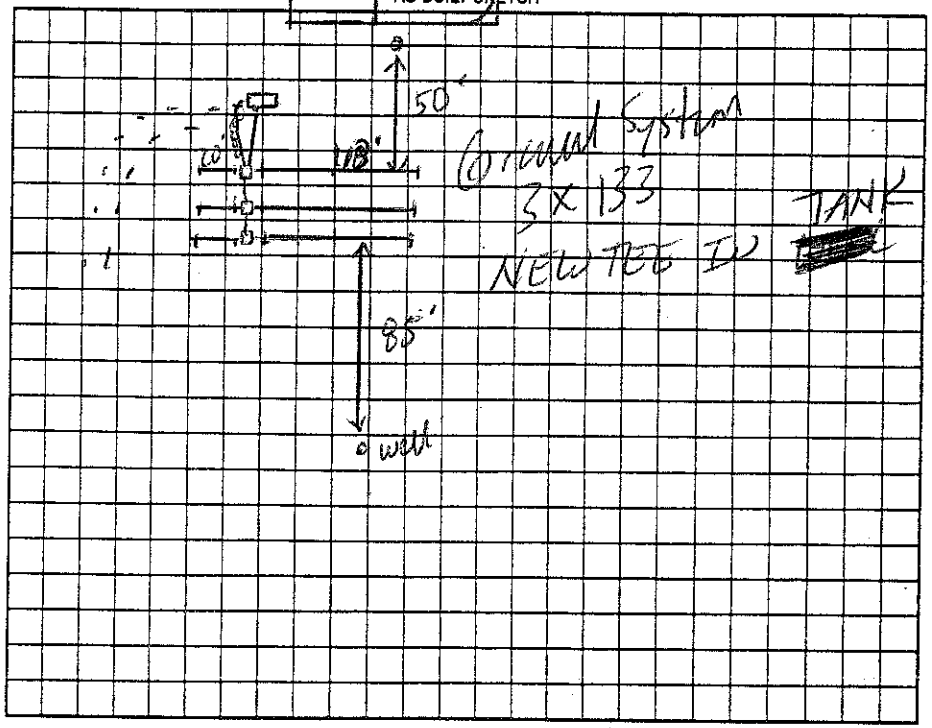

Permit can be suspended or revoked if any false information is supplied toward securing the permit/any unauthorized changes are made to the site/any unauthorized changes are made in the installation of the system. Improvement Permit with plat valid without expiration ☐ Improvement Permit with site plan valid for sixty months ☒ Authorization to Construct is valid for a period equal to that of Improvement Permit – not to exceed sixty months.

Signed: _____ date _____

Improvement Permit by: _____ date 11/19/07

Authorization to Construct by: _____ date 11/19/07

Installed by: SAMMY LEWIS

Operation Permit by: _____ date 11-19-07

Existing System Inspection by: _____ date _____

HEALTH DEPT. COPY: WHITE OWNER COPY (FINAL): YELLOW OWNER COPY (INITIAL): PINK