IREDELL COUNTY HEALTH DEPARTMENT

STATESVILLE 704-878-5305 MOORESVILLE 704-664-5281

IMPROVEMENT PERMIT / AUTHORIZATION TO CONSTRUCT / OPERATION PERMIT / EXISTING SYSTEM INSPECTION

PERMIT# REPAIR PIN# DATE 2-24-00

OWNER OR CONTRACTOR GALE W. HUIE PHONE: Business Home 546-7501

ADDRESS 4530 HARMONY HWY, HAMPTONVILLE, NC 27020

LOCATION US 21 NORTH, HOUSE ON RIGHT ACROSS FROM HUNTING CREEK ROAD

SUBDIVISION BLOCK / SECTION LOT LOT AREA ~1 ACRE SITE CLASS. PS DESIGN FLOW 360 L.T.A.R. EXISTING

Septic Tank: EXISTING Gallons; STB Date

Pump Tank: Gallons; PT Date

Pump Make: Model Serial No.

Nitrification Field: No Fields 1 Square Feet 480 Linear Feet 160

No Lines TWO Trench Width 36" Max Trench Bottom Depth 36" Gravel Depth 12"

☐ New System ☑ Repair System Type: I (II) III, IV, V, VI

System Description: CONVENTIONAL GRAVITY

Repair System Description: CONV. GRAVITY

Maintenance Agreement Required: ☐ Yes ☑ No

☐ Slab ☐ Crawl Space ☐ Basement w/plumbing ☑ Basement wo/plumbing

☑ House/Mod. Home No. Bedrooms 3

☐ Mobile Home No. Bathrooms 1½

☐ Business No. Employees


☐ Other

Water Supply: ☑ Individual ☐ Public ☐ Community WELL

Comments:/Conditions:

Comments:/Conditions:

INITIAL SITE SKETCH

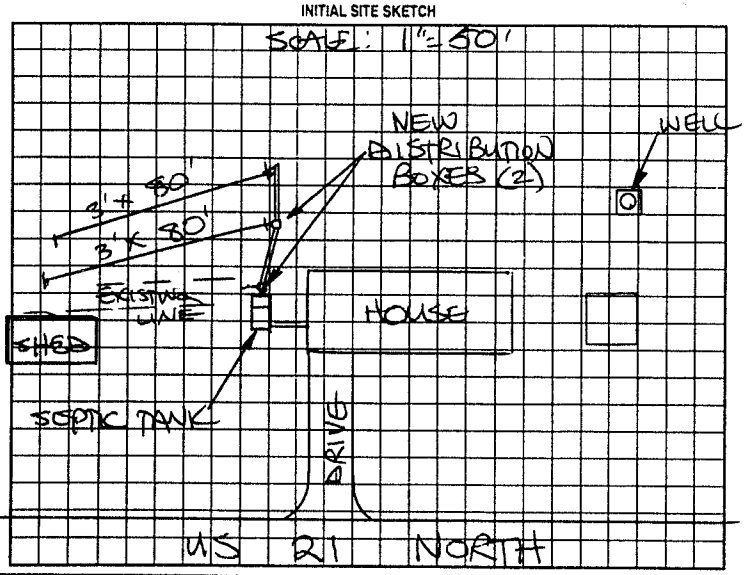

AS BUILT SKETCH

SYSTEM REPAIRED ACCORDING TO INITIAL SITE SKETCH

Permit can be suspended or revoked if any false information is supplied toward securing the permit/any unauthorized changes are made to the site/any unauthorized changes are made in the installation of the system. Improvement Permit with plat valid without expiration. Improvement Permit with site plan valid for sixty months. Authorization to Construct is valid for a period equal to that of Improvement Permit – not to exceed sixty months.

Signed: [signature] date 2/24/00 Installed by: SAMMY REAVIS

Improvement Permit by: STEVE HEDRICK date 2-24-00 Operation Permit by: STEVE HEDRICK date 3-2-00

Authorization to Construct by: STEVE HEDRICK date 2-24-00 Existing System Inspection by: date

HEALTH DEPT. COPY: WHITE OWNER COPY (FINAL): YELLOW OWNER COPY (INITIAL) PINK