ICHD - ENVIRONMENTAL HEALTH DIVISION

Statesville Office (704) 878-5305 Mooresville Office (704) 660-3625

PERMIT # OSWP 2023 38048

SEPTIC: IMPROVEMENT PERMIT / AUTHORIZATION TO CONSTRUCT / OPERATION PERMIT / EXISTING SYSTEM

PIN # 4873 -- 92 -- 2874

APPLICANT/OWNER: Chrstopher Kim APPLICANT ADDRESS: 2026 Northside Dr. Statesville NC 28677

SITE ADDRESS: 4600 Harmony Hwy Hamptonville NC 27020 PHONE: 843 493 6221 ALT. PHONE —

SITE DIRECTIONS: Hwy 21 N → site on (R) SAP CONTROLLED: [X] YES [ ] NO


SUBDIVISION: — SECTION: — LOT # — LOT AREA: 2.08 DESIGN FLOW: 240 L.T.A.R.: EXT

EXISTING

Septic Tank	(gal)	STB	Date	[ ] New System [ ] Repair [ ] Expansion System Type: I II (III) IV V VI	[X] Residence	No. Bedrooms	2	**Water Supply**	
Pump Tank	(gal)	PT	Date	System Description: EXISTING 25% Reduction	[ ] Business	No. Persons	4	[X] Private	
Pump Make	Model		Serial #	Repair System Description: 25% Reduction	[ ] Other	No. Employees	—	[ ] Public	
# Nitrification Fields	# Lines		Linear Ft.	Maintenance Agreement Required: [ ] YES [X] NO	[ ] Slab	[X] Crawl Space		[ ] Community	
Trench Width	Trench Bottom Depth(Low side)		Gravel Depth	[X] GRAVITY [ ] PRESSURE	[ ] Basement w/plumbing			[ ] Basement w/o plumbing	

Comments / Conditions: System functioning properly at time of inspection.

INITIAL SITE SKETCH

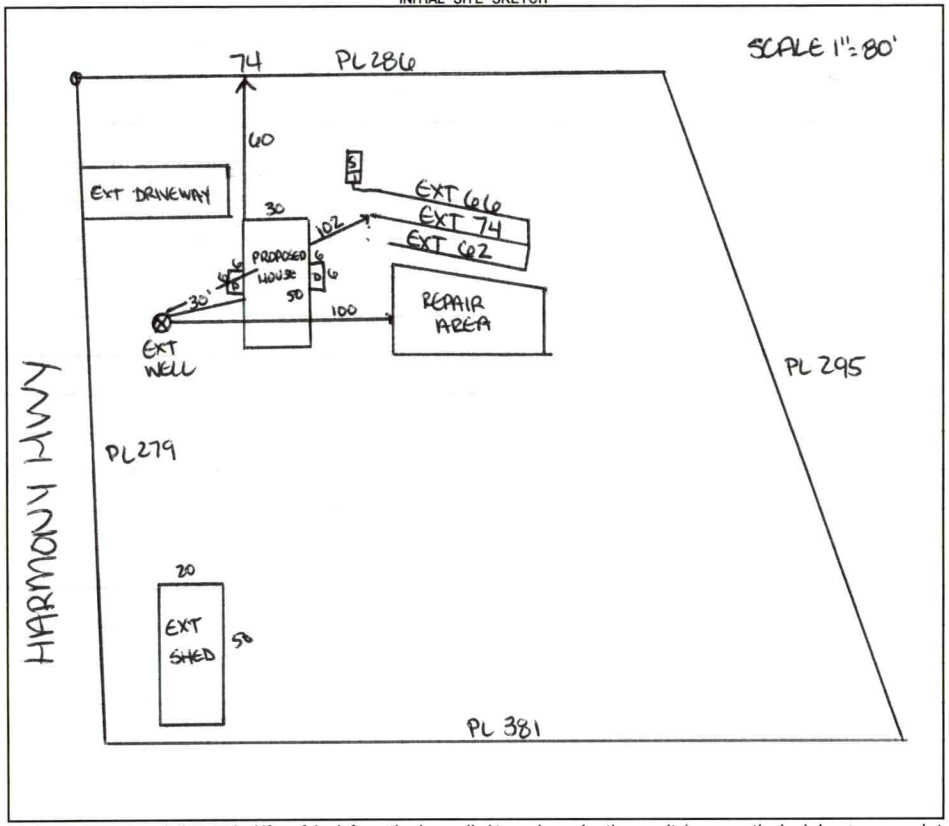

AS BUILT SKETCH

FOR SEPTIC FINAL INSPECTION CALL: 704-664-3703 between 8am-9am the day the inspection is needed. Be sure to speak with an inspector to confirm your time.

Permit can be suspended or revoked if any false information is supplied toward securing the permit / any unauthorized changes are made to the site / any unauthorized changes are made in the installation of the system. **CONTACT A LOCATOR SERVICE PRIOR TO ANY EXCAVATION**

[ ] **IMPROVEMENT PERMIT** ***with plat*** *valid without expiration.* [ ] **IMPROVEMENT PERMIT** ***with site plan*** *valid for 60 mos.* [X] **AUTHORIZATION TO CONSTRUCT** *valid for period equal to IMPROVEMENT PERMIT--not to exceed 60 mo.*

Owner / Applicant Signature: ONLINE Date: — Installed by:


IMPROVEMENT PERMIT by: Date: OPERATION PERMIT by: Date:

AUTHORIZATION TO CONSTRUCT by: Date: Existing System Inspected by: Sarah Williams Date: 11/17/2023

FOR SEPTIC FINAL INSPECTION: CALL 704-664-3703 between 8am-9am the day the inspection is needed.

Item	Date	Initials
Drain Lines Checked		
Tanks Checked		
Pressure Manifold or Valve Box Checked		
Pressure Head Set		
Electrical Checked		
Floats Set		
Alarm Checked		
Maintenance Contract Needed? Y / N		
Comments:		

Repairs Only	
	State Code
Failing System Code	
Type of Distribution	G or P
Type of Failure/Malfunction	
Primary Cause of Failure/Malfunction	
Age of System? _____	
Initial or Repair? _____	

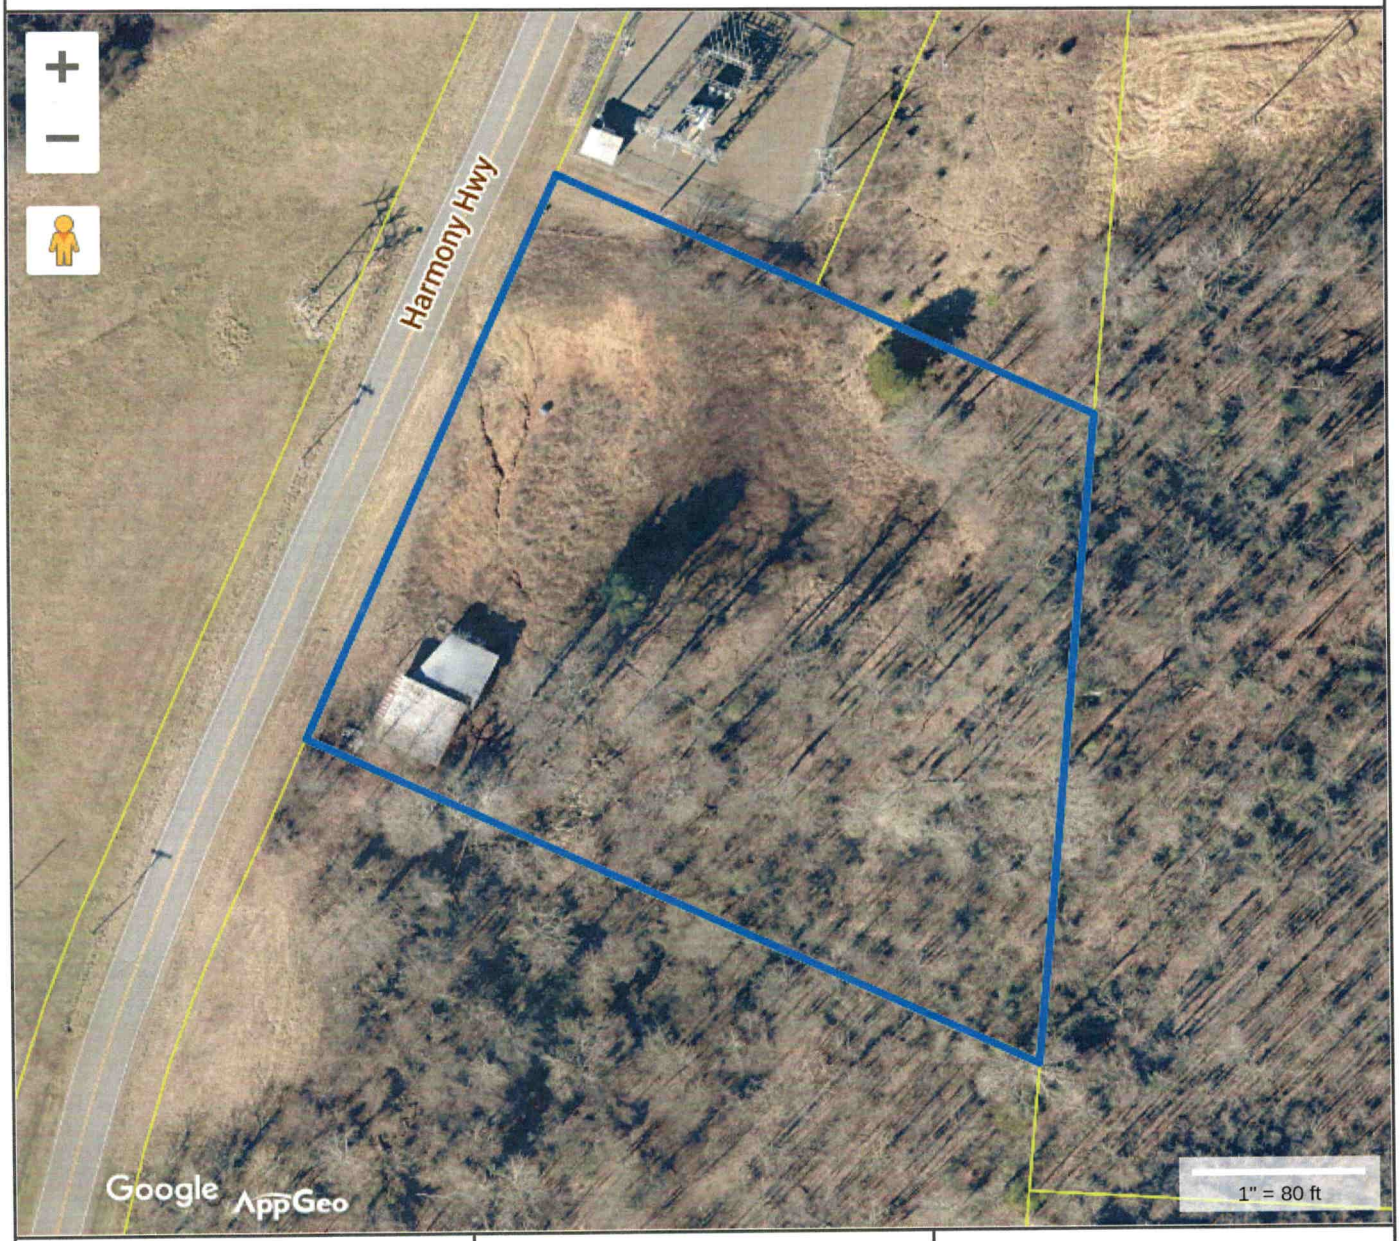

Tax Map Information

• PIN	4873922874.000
• Address	4600 HARMONY HWY
• Account #	Acct 80102900
• Tax Owner	KLIM CHRISTOPHER MARTIN
• Mailing Address	4600 HARMONY HWY
•	HARMONY, NC 28634
• GIS Owner	KLIM CHRISTOPHER M
• Deed Info	2997 / 2313 - WD - 20230614
• Tax Acres	2.08 AC
• Lot #	
• Description	JOHNSON US21
• Zoning	RU-R
• Old Parcel #	0617K00000A006
• Bldg Value	$0
• OBXF Value	$3,760
• Land Value	$29,480
• Total Value	$33,240
• Defer Value	$0
• Tax Districts	-ALLCNTY FIRE- -


IREDELL COUNTY NC

MAP FOR REFERENCE ONLY
NOT A LEGAL DOCUMENT

Iredell County, North Carolina makes no claims and no warranties, expressed or implied, concerning the validity or accuracy of the GIS data presented on this map.

Geometry updated 11/15/2023
Data updated 11/14/2023

Print map scale is approximate. Critical layout or measurement activities should not be done using this resource.

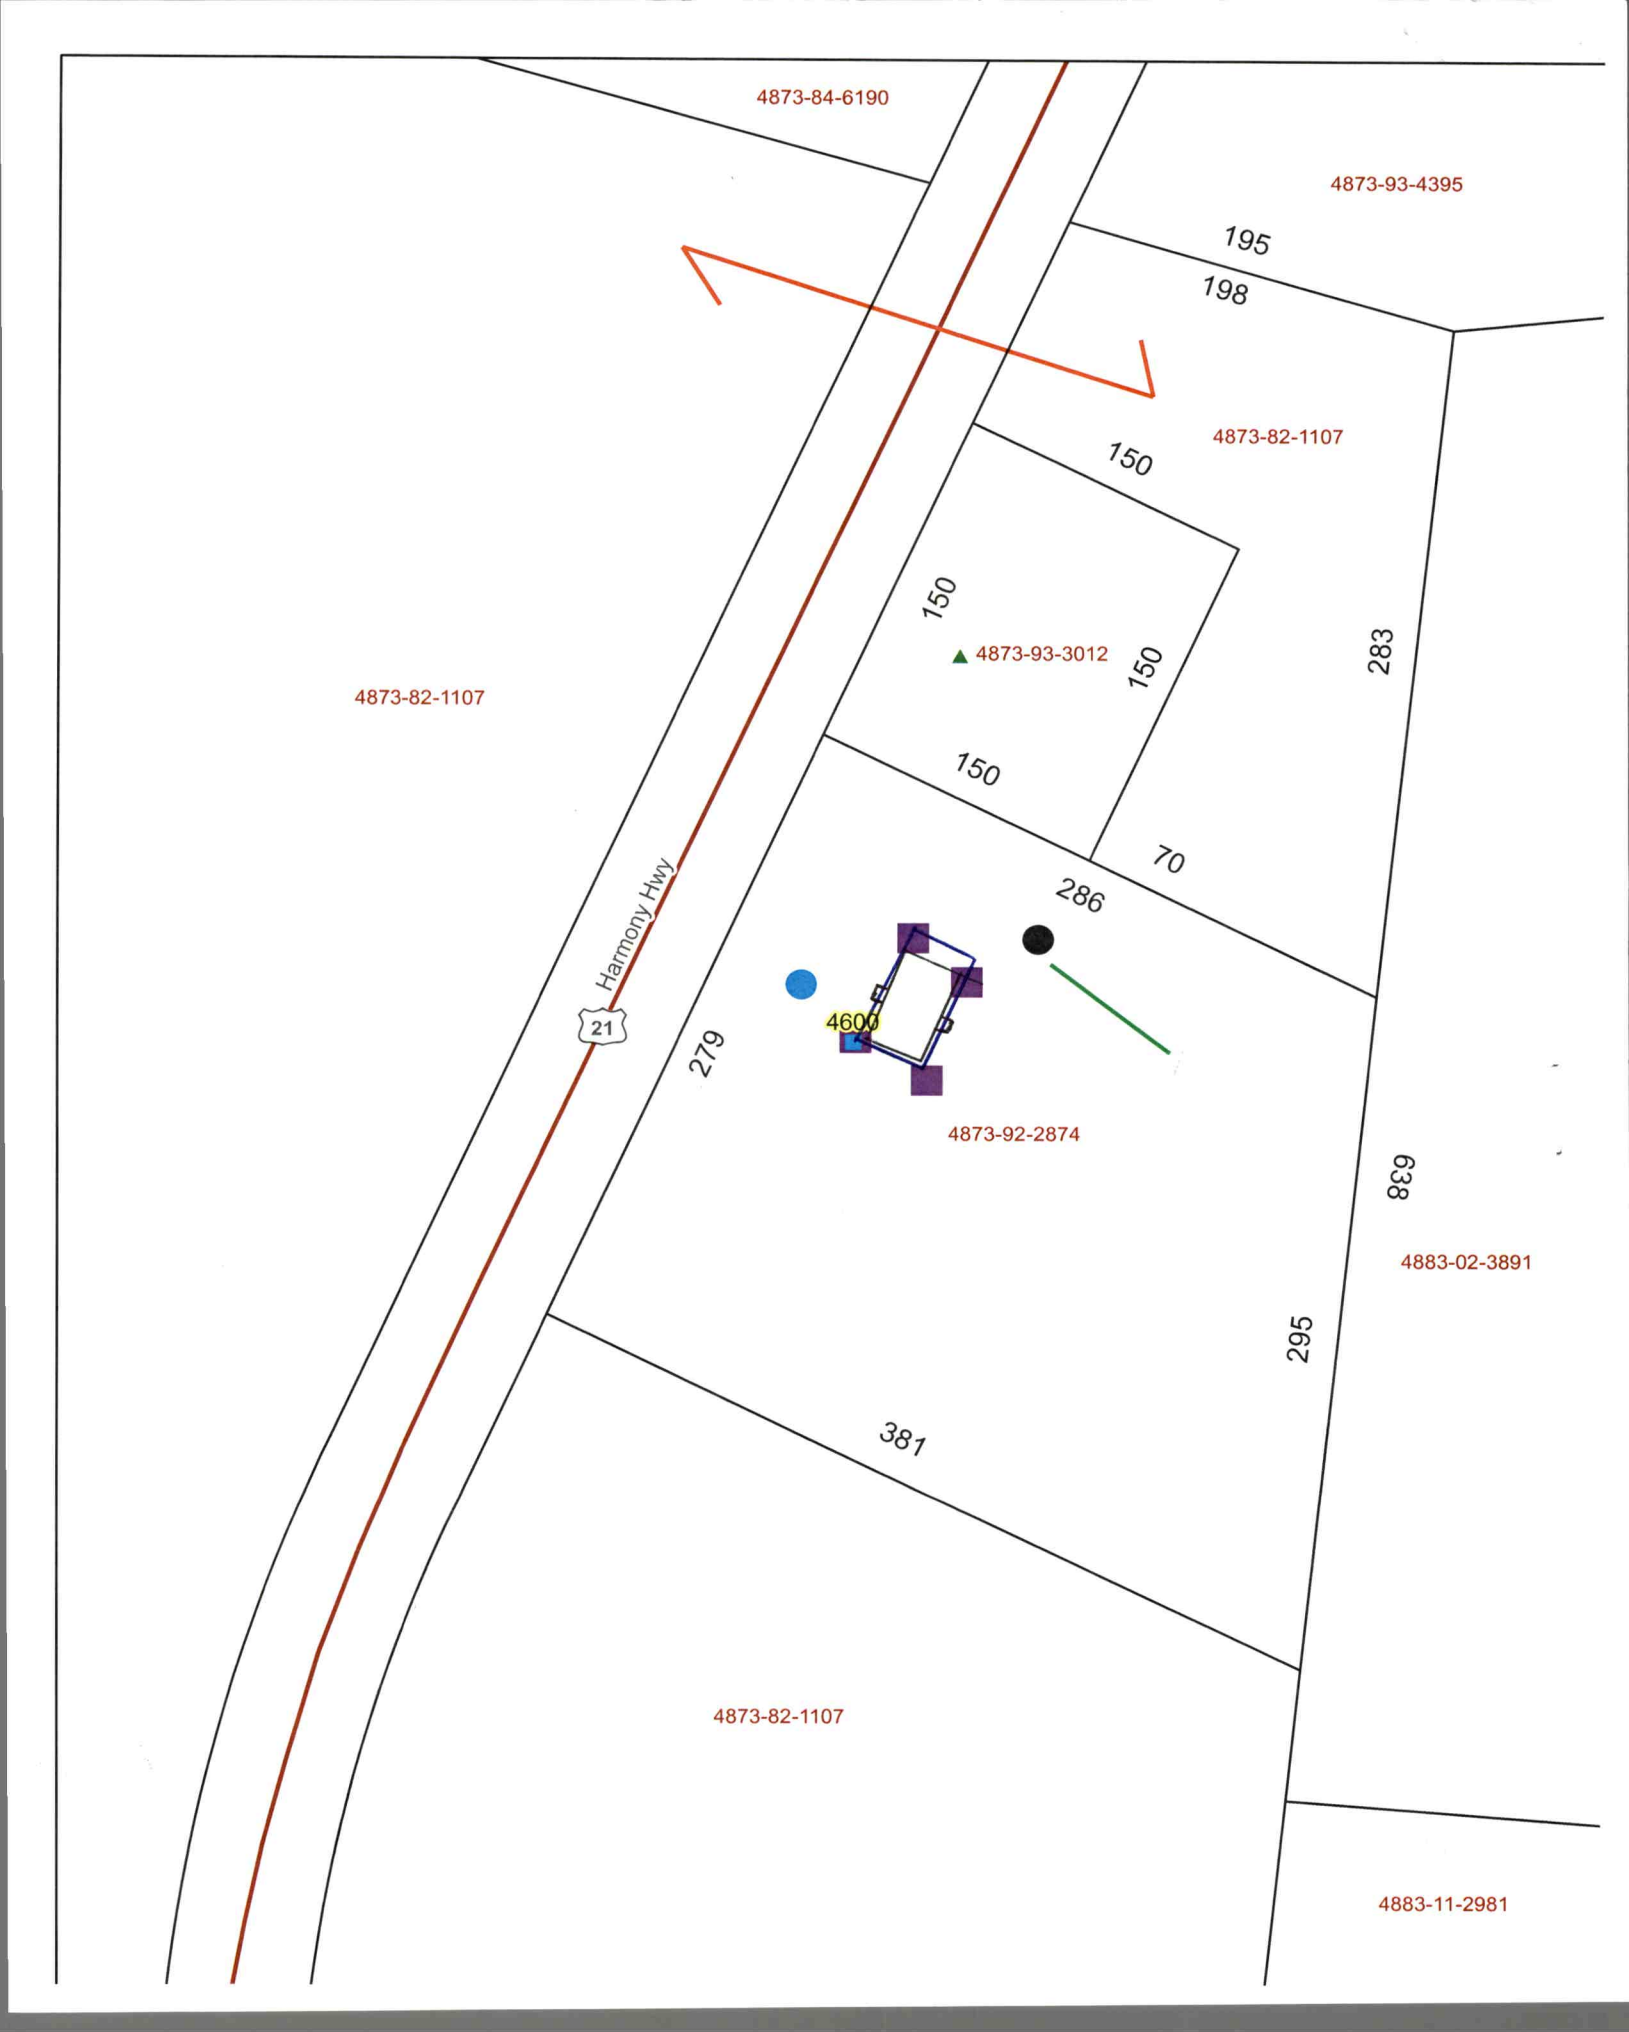
4873-84-6190
4873-93-4395
195
198
4873-82-1107
150
150
4873-93-3012
150
283
4873-82-1107
150
70
286
Harmony Hwy
21
4600
279
4873-92-2874
638
4883-02-3891
295
381
4873-82-1107
4883-11-2981

IREDELL COUNTY HEALTH DEPARTMENT — PERMIT # 040750

SEPTIC IMPROVEMENT PERMIT / AUTHORIZATION TO CONSTRUCT / OPERATION PERMIT / EXISTING SYSTEM — **PIN #** 4873922874

APPLICANT/OWNER: Charlie Barney — APPLICANT ADDRESS: 187 Amberhill Rd

SITE ADDRESS: 1000 Harmony Hwy, Hamptonville, 27020 — PHONE: 704-546-6937 — ALT. PHONE —

SITE DIRECTIONS: US21 N → 15 miles on right — SAP CONTROLLED: ☒ YES ☐ NO

SUBDIVISION: — — SECTION: — — LOT # — — LOT AREA: 2.08 — DESIGN FLOW: 240 gpd — L.T.A.R.: .3


Septic Tank	1000 (gal)	STB	856	Date	10/30/18	☒ New System	☐ Repair	☐ Expansion	System Type: I II (III) IV V VI	☒ Residence	No. Bedrooms 2
Pump Tank	(gal)	PT		Date		System Description:		25% reduction		☐ Business	No. Persons 4
Pump Make		Model		Serial #		Repair System Description:		25% reduction		☐ Other	No. Employees
# Nitrification Fields	1	# Lines	3	Linear Ft	200	Maintenance Agreement Required:	☐ YES	☒ NO		☐ Slab	☒ Crawl Space
Trench Width	36"	Trench Bottom Depth(Low side)	22"	Gravel Depth	—		☒ GRAVITY	☐ PRESSURE		☐ Basement w/plumbing	☐ Basement w/o plumbing

Water Supply: ☒ Private ☐ Public ☐ Community


Comments / Conditions: Install on contour & utilize serial distribution. Pump, crush, & fill old existing tank.

* Sap controlled - must be 100' from well *

INITIAL SITE SKETCH

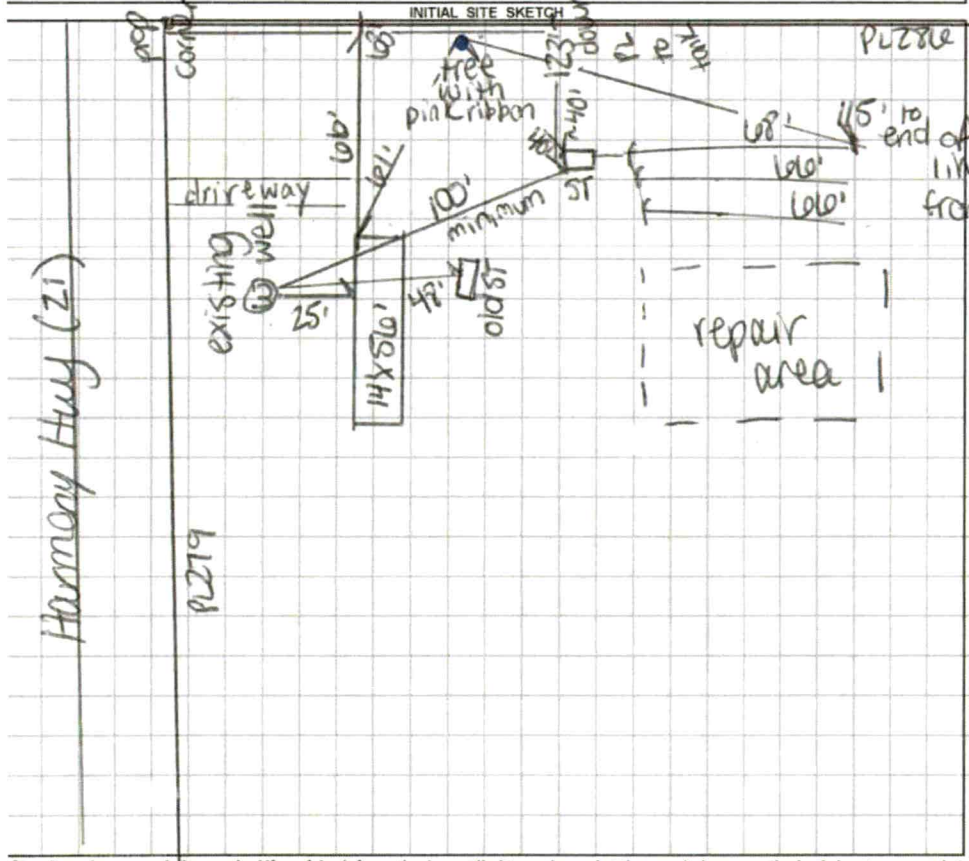

AS BUILT SKETCH

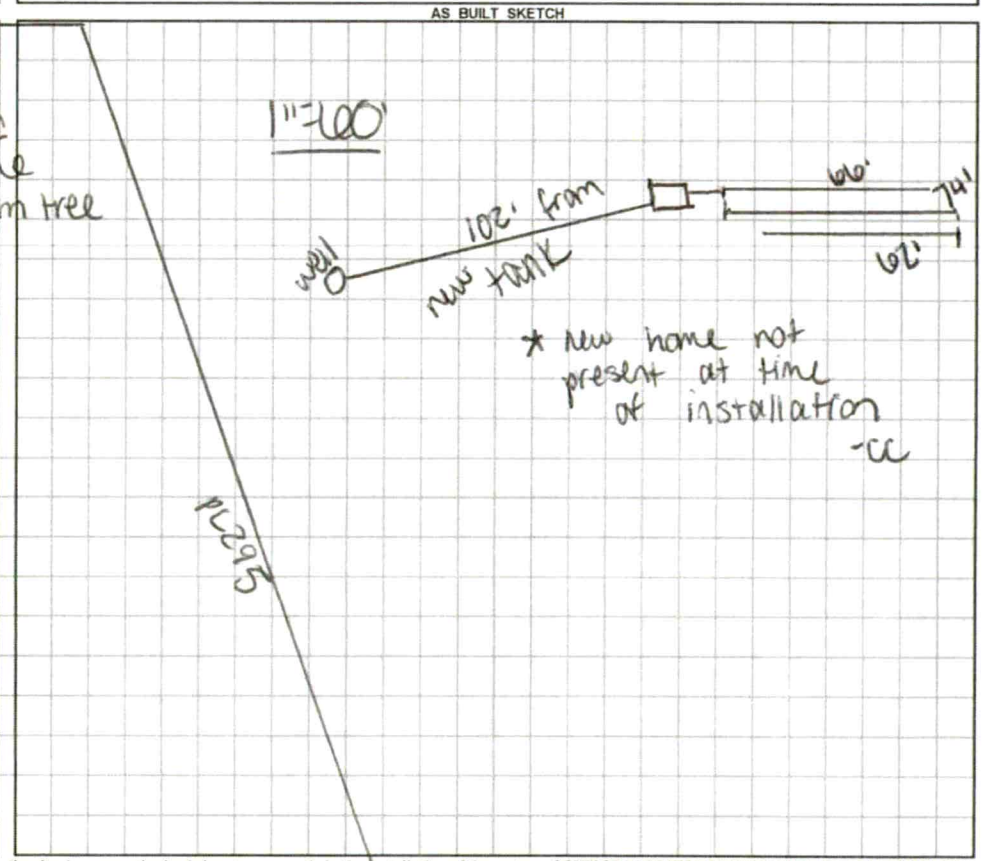

Permit can be suspended or revoked if any false information is supplied toward securing the permit / any unauthorized changes are made to the site / any unauthorized changes are made in the installation of the system. **CONTACT A LOCATOR SERVICE PRIOR TO ANY EXCAVATION**

☐ IMPROVEMENT PERMIT ***with plat*** *valid without expiration.* ☒ IMPROVEMENT PERMIT ***with site plan*** *valid for 60 mos.* ☒ AUTHORIZATION TO CONSTRUCT *valid for period equal to IMPROVEMENT PERMIT--not to exceed 60 mo.*


Owner / Applicant Signature: Charlie Barney — Date: 1-18-2019 — Installed by: A1 Backhoe

IMPROVEMENT PERMIT by: Carla C. Cave — Date: 1/17/19 — OPERATION PERMIT by: Carla C. Cave — Date: 1/18/19

AUTHORIZATION TO CONSTRUCT by: Carla C. Cave — Date: 1/17/19 — Existing System Inspected by: — Date: —

FOR SEPTIC FINAL INSPECTION: CALL 704-664-3703 between 8am-9am the day the inspection is needed. Be sure to speak with an inpsector to confirm your inspection time.

Satisfaction

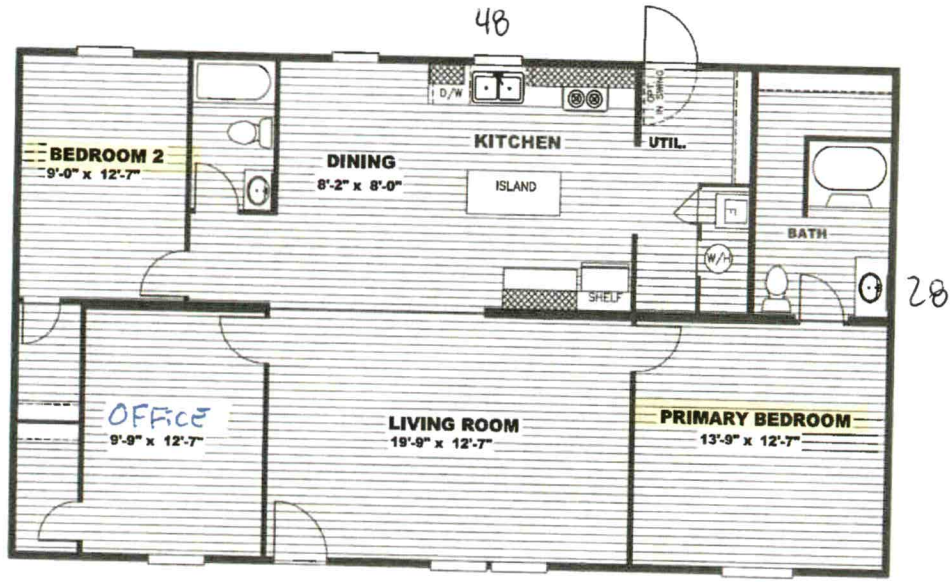

4E

10-2-23

Model #: TRU28483R

28' x 48' Satisfaction