IREDELL COUNTY HEALTH DEPARTMENT

STATESVILLE 704-878-5305 MOORESVILLE 704-664-5281

IMPROVEMENT PERMIT / AUTHORIZATION TO CONSTRUCT / OPERATION PERMIT / EXISTING SYSTEM INSPECTION

PERMIT# 76435 PIN# 4883 03 4542 DATE 9-24-98

OWNER OR CONTRACTOR Benny W Barnard PHONE: Business Home 546 2689

ADDRESS 4648 Harmony Hwy Hamptonville, N.C.

LOCATION Harmony Hwy cross Huntin, creek pass Sub-station behind 1st Hse Rt

SUBDIVISION BLOCK / SECTION LOT LOT AREA 85 acres SITE CLASS. PS DESIGN FLOW 360 L.T.A.R. 1.33

Septic Tank: 1000 Gallons; STB 620 Date 9-2-98

Pump Tank: Gallons; PT Date

Pump Make: Model Serial No.

Nitrification Field: No Fields 1 Square Feet 1080 Linear Feet 360

No Lines 4 Trench Width 36" Max Trench Bottom Depth 36" Gravel Depth 12"

☑ New System ☐ Repair System Type: I, II, III, IV, V, VI

System Description: Conv. Gravity

Repair System Description: " "

Maintenance Agreement Required: ☐ Yes ☑ No

☐ House/Mod. Home ☑ Mobile Home ☐ Business ☐ Other

No. Bedrooms 3 No. Bathrooms 2 No. Employees

Water Supply: ☑ Individual ☐ Public ☐ Community well next door


☐ Slab ☑ Crawl Space ☐ Basement w/plumbing ☐ Basement wo/plumbing

Comments:/Conditions:


US 21

Comments:/Conditions:

INITIAL SITE SKETCH

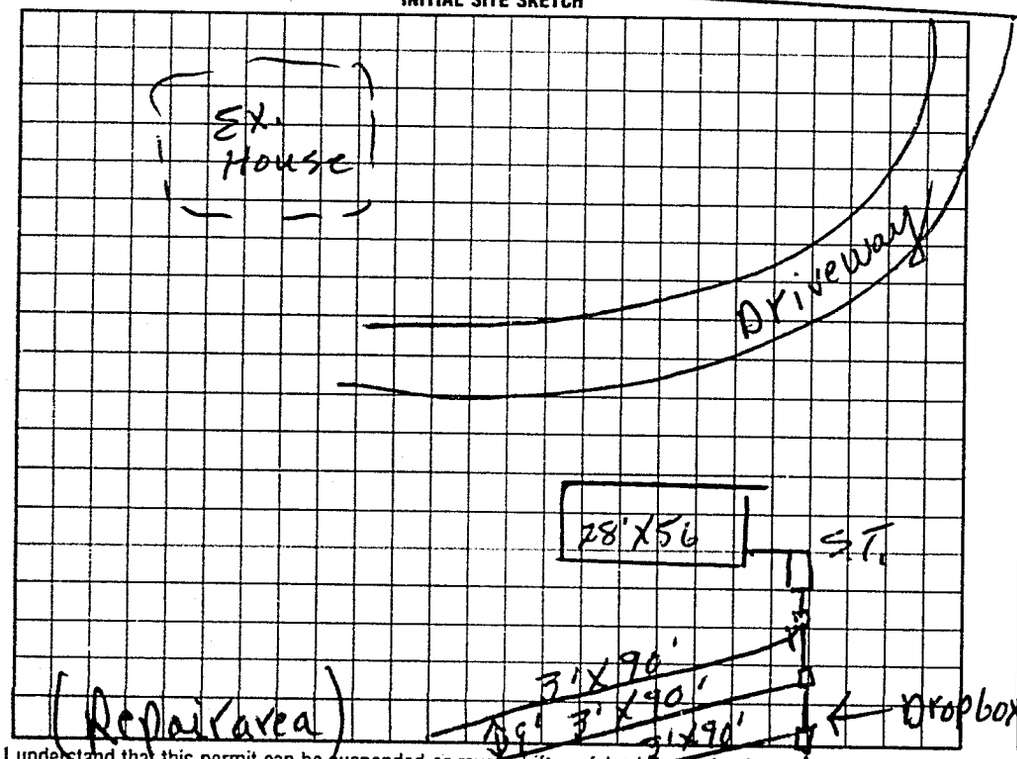

AS BUILT SKETCH

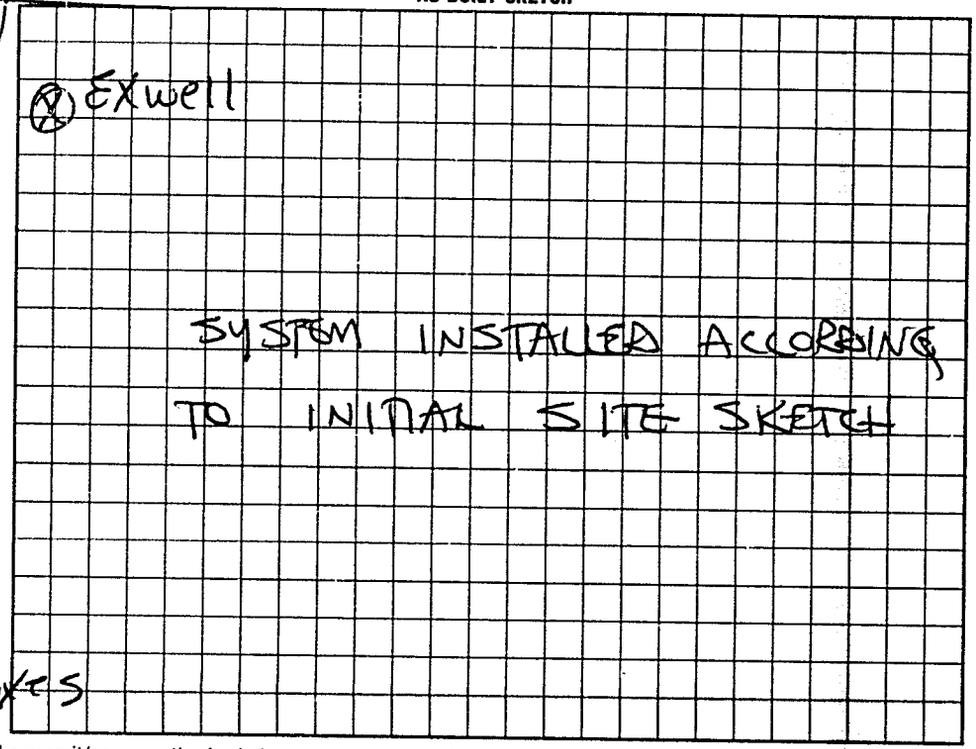

I understand that this permit can be suspended or revoked if any false information is supplied toward securing the permit/any unauthorized changes are made to the site/any unauthorized changes are made in the installation of the system. Improvement Permit with plat valid without expiration. Improvement Permit with site plan valid for sixty months. Authorization to Construct is valid for a period equal to that of Improvement Permit – not to exceed sixty months.

Signed: x Benny W Barnard date 9-24-98 Installed by: Tommy Nixon

Improvement Permit by: P.C. Moore date 9-24-98 Operation Permit by: Steve Hedrick date 10-19-98

Authorization to Construct by: P.C. Moore date 9-24-98 Existing System Inspection by: date

HEALTH DEPT. COPY: WHITE INSPECTION COPY (FINAL): GREEN OWNER COPY (FINAL): YELLOW INSPECTION COPY (INITIAL): PINK OWNER COPY (INITIAL): GOLD