IREDELL COUNTY HEALTH DEPARTMENT

STATESVILLE 704-878-5305 MOORESVILLE 704-664-5281

IMPROVEMENT PERMIT / CERTIFICATE OF COMPLETION / OPERATION PERMIT / EXISTING SYSTEM INSPECTION

PROPERTY DESCRIPTION NO. 17405 DATE 11/18/93 TAX MAP NO. 17N-A-38 Watershed: ☐ Yes ☑ No

OWNER OR CONTRACTOR C.C. CARSON c/o NANNIE LEWIS PHONE: Business Home 546-7559

ADDRESS RT-1 Box 499 HAMPTONVILLE NC 27020

LOCATION US 21 N, ON (R), BEHIND 6TH HOUSE PAST HUNTING CREEK

SUBDIVISION BLOCK / SECTION LOT LOT AREA ~5 ACRES SITE CLASS. PS DESIGN FLOW 240 GPD L.T.A.R. 0.35 GPD/FT²

Septic Tank: 1000 Gallons; STB 358 Date 10/20/93

Pump Tank: Gallons; PT Date

Pump Make: Model Serial No.

Nitrification Field: No Fields 1 Square Feet 690 Linear Feet 230

No Lines 3 Trench Width 36" Max Trench Bottom Depth 18-36" Gravel Depth 12"

☑ New System ☐ Repair System Type: I, II, III, IV, V, VI

System Description: CONV. GRAVITY

Repair System Description: CONV. GRAVITY

Maintenance Agreement Required: ☐ Yes ☑ No

☐ House/Mod. Home ☑ Mobile Home ☐ Business ☐ Other

No. Bedrooms 2 No. Bathrooms 2 No. Employees


☐ Slab ☑ Crawl Space ☐ Basement w/plumbing ☐ Basement wo/plumbing

Water Supply: ☑ Individual ☐ Community ☐ Public WELL

Comments: ① KEEP SYSTEM MINIMUM 5' FROM MH, 10' FROM PROPERTY LINE, 20' FROM PIT PRIVY ② INSTALL LINES ON CONTOUR, NO DEEPER THAN 36", 9' O.C.

Comments:

INITIAL SITE SKETCH

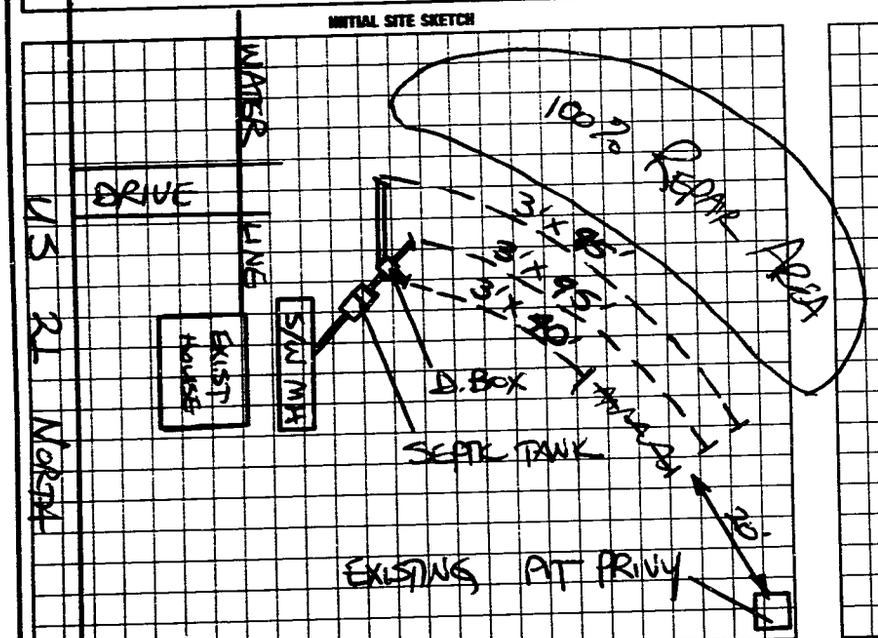

AS BUILT SKETCH

SYSTEM INSTALLED ACCORDING TO INITIAL SITE SKETCH

I understand that this permit can be suspended or revoked if any false information is supplied toward securing the permit/any unauthorized changes are made to the site/any unauthorized changes are made in the installation of the system. Improvement Permit is valid for 60 months from date of issuance.

Signed: X Daniel Moore

Improvement Permit by: STEVE HERRICK date 11/18/93

Existing System Inspection by: date

Installed by: A-1 BACKHOE

Certificate of Completion by: STEVE HERRICK date 11/30/93

Operation Permit by: date

HEALTH DEPT. COPY: WHITE INSPECTION COPY (FINAL): GREEN OWNER COPY (FINAL): YELLOW INSPECTION COPY (INITIAL): PINK OWNER COPY (INITIAL): GOLD