IREDELL COUNTY HEALTH DEPARTMENT

STATESVILLE 704-878-5305 MOORESVILLE 704-664-5281

IMPROVEMENT PERMIT / CERTIFICATE OF COMPLETION / OPERATION PERMIT / EXISTING SYSTEM INSPECTION

PROPERTY DESCRIPTION NO. 16448 DATE 6/10/93 TAX MAP NO. 17N-A-26

OWNER OR CONTRACTOR VIVIAN SMITH PHONE: Business Home 596-2266 / 596-7887

ADDRESS Rt. 1 Box 496, HAMPTONVILLE, NC 27020

LOCATION US 21 N, THRU HARMONY, ON (L) JUST PAST PLEASANT HILL BAPT. CH, BACK BEHIND WOODED AREA

SUBDIVISION BLOCK / SECTION LOT LOT AREA SITE CLASS. L.T.A.R.

Water Supply: ☑ Individual ☐ Community ☐ Public WELL TO BE LOCATED

Septic Tank: 1000 Gallons; STB 825 Date 4/15/93

Pump Tank: Gallons; PT Date

Nitrification Field: No Fields 1 Square Feet 1035 Linear Feet 345

No Lines 3 Trench Width 36" Trench Depth 36" Gravel Depth 12"

☑ New System ☐ Repair System Type: I, II, III, IV, V, VI

System Description: CONV. GRAVITY

Repair System Description: CONV. GRAVITY

Maintenance Agreement Required: ☐ Yes ☑ No

☐ House/Mod. Home ☑ Mobile Home ☐ Business ☐ Other

No. Bedrooms 3 No. Bathrooms 2 No. Employees

Garbage Disposal: ☐ Yes ☐ No

Auto. Dishwasher: ☑ Yes ☐ No


Auto. Washing Machine: ☑ Yes ☐ No

Other

☐ Slab ☑ Crawl Space ☐ Basement w/plumbing ☐ Basement wo/plumbing

Comments

INITIAL SITE SKETCH

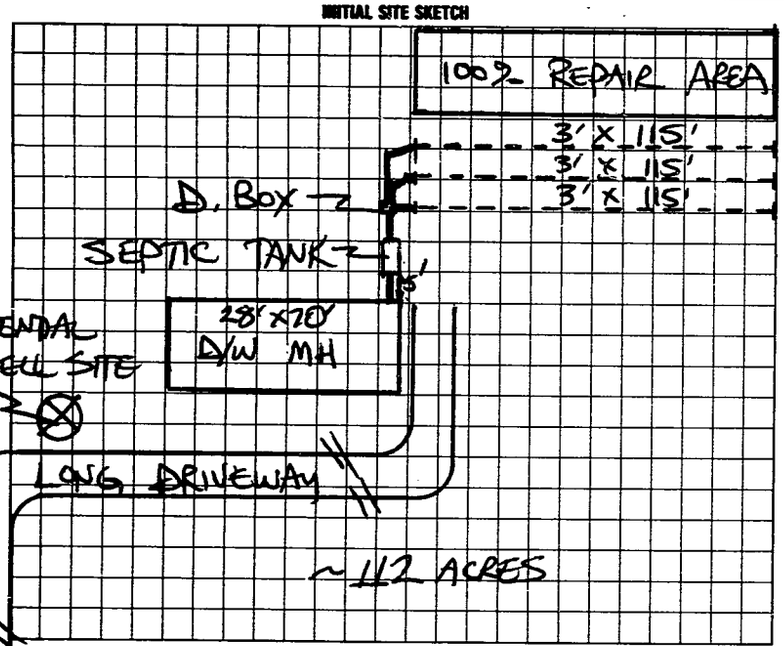

AS BUILT SKETCH

INSTALLED ACCORDING TO INITIAL SITE SKETCH

I understand that this permit can be suspended or revoked if any false information is supplied toward securing the permit/any unauthorized changes are made to the site/any unauthorized changes are made in the installation of the system. Improvement Permit is valid for 60 months from date of issuance.

Signed: Darrell Smith

Improvement Permit by: STEVE HEDRICK date 6/10/93

Existing System Inspection by: date

Installed by: BILL CUTHBERTSON

Certificate of Completion by: STEVE HEDRICK date 6/23/93

Operation Permit by: date

US 21 NORTH → HEALTH DEPT. COPY (FINAL): BLUE INSPECTION COPY (FINAL): GREEN OWNER COPY (FINAL): YELLOW INSPECTION COPY (INITIAL): PINK OWNER COPY (INITIAL): GOLD