IREDELL COUNTY HEALTH DEPARTMENT

STATESVILLE 704-878-5305 MOORESVILLE 704-664-5281

CF

IMPROVEMENT PERMIT / AUTHORIZATION TO CONSTRUCT / OPERATION PERMIT / EXISTING SYSTEM INSPECTION

PERMIT# 109297 PIN# 4873-99-5030 DATE 10-23-02

OWNER OR CONTRACTOR FLEETWOOD HOMES of STATESVILLE PHONE: Business 704-872-0179 Home

ADDRESS 1270 NORTHSIDE DR STATESVILLE, NC 28677

LOCATION US 21 N, THROUGH HARMONY ON LEFT BEFORE NEW HOPE BAPTIST CHURCH

SUBDIVISION GRANTS GLEN BLOCK / SECTION LOT 21 LOT AREA 0.685 ACRES SITE CLASS PS DESIGN FLOW 360 L.T.A.R. 0.30 GPD/FT²

Septic Tank: 1000 Gallons: STB 1012 Date 7-15-02
Pump Tank: Gallons: PT Date
Pump Make: Model Serial No.
Nitrification Field: No Fields 1 Square Feet 28.10/200 Linear Feet 300
No Lines FIVE Trench Width 36" Max Trench Bottom Depth 36" Gravel Depth N/A

☑ New System ☐ Repair System Type: I. II. III. IV. V. VI
System Description: 25% REDUCTION GRAVITY
Repair System Description: 25% REDUCTION, pump
Maintenance Agreement Required: ☐ Yes ☑ No
☐ Slab ☑ Crawl Space ☐ Basement w/plumbing ☐ Basement wo/plumbing


☐ House/Mod. Home No. Bedrooms 3
☑ Mobile Home No. Bathrooms 2
☐ Business No. Employees
☐ Other

Water Supply: ☑ Individual ☐ Public ☐ Community
WELL


Comments/Conditions: ① FILL EXISTING GULLY WITH CLEAN CLAY SOIL ② INSTALL 25% REDUCTION SYSTEM ON CONTOUR AS SHOWN

Comments/Conditions: HOUSE SLAB HIGH 10" TUFF TITE FILTER FABRIC LITTLE MORE REPAIR IN THE FRONT YARD. REPAIR IS THE SAME.

INITIAL SITE SKETCH

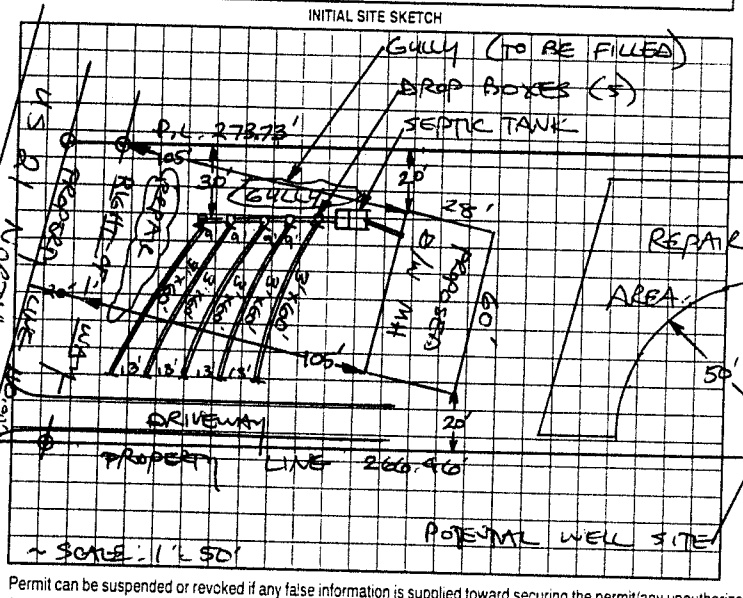

AS BUILT SKETCH

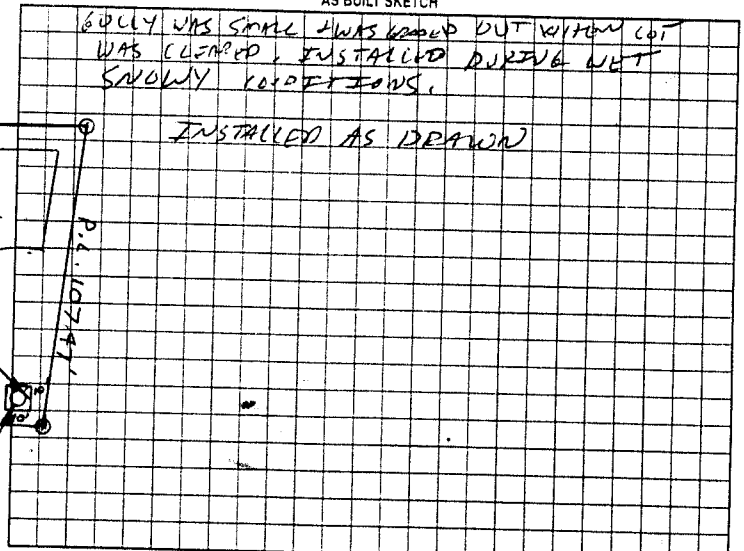

Permit can be suspended or revoked if any false information is supplied toward securing the permit/any unauthorized changes are made to the site any unauthorized changes are made in the installation of the system. Improvement Permit with plat valid without expiration. Improvement Permit with site plan valid for sixty months. Authorization to Construct is valid for a period equal to that of Improvement Permit – not to exceed sixty months.

Signed: date 11-8-02 Installed by: CRAIG THOMPSON

Improvement Permit by: STEVE HEDRICK date 10-23-02 Operation Permit by: date 12-4-02

Authorization to Construct by: STEVE HEDRICK date 10-23-02 Existing System Inspection by: date

HEALTH DEPT COPY: WHITE OWNER COPY (FINAL): YELLOW OWNER COPY (INITIAL): PINK