IREDELL COUNTY HEALTH DEPARTMENT

STATESVILLE 704-878-5305 (C1) MOORESVILLE 704-664-5281

IMPROVEMENT PERMIT / AUTHORIZATION TO CONSTRUCT / OPERATION PERMIT / EXISTING SYSTEM INSPECTION

PERMIT# 107511 PIN# 4873-99-5125.3 DATE 7/16/02

OWNER OR CONTRACTOR Piedmont Charlotte Developers PHONE: Business (704) 883-9997 Home ____

ADDRESS 134 KOA Lane Statesville, NC. 28677

LOCATION US 21 North Cross Hunting Creek, ON Left before New Hope Baptist Church

SUBDIVISION Grants Glen BLOCK / SECTION — LOT 3 LOT AREA .713Ac SITE CLASS PS DESIGN FLOW ____ L.T.A.R. 0.40 gpd

Septic Tank: 4000 Gallons: STB 1017 Date 7-2-02
Pump Tank: ____ Gallons: PT ____ Date ____
Pump Make: ____ Model ____ Serial No. ____
Nitrification Field: No. Fields 1 Square Feet 900 Linear Feet 300
No. Lines 4 Trench Width 36" Max Trench Bottom Depth 36" Gravel Depth 12"

[X] New System [ ] Repair System Type: I (II, III, IV, V, VI)
System Description: Gravity, Conventional
Repair System Description: Gravity, 25% Reduction
Maintenance Agreement Required: [ ] Yes [X] No

[ ] House/Mod. Home No. Bedrooms 3
[X] Mobile Home No. Bathrooms 2
[ ] Business No. Employees ____
[ ] Other ____
[ ] Slab [X] Crawl Space [ ] Basement w/plumbing [ ] Basement wo/plumbing


Water Supply: [X] Individual [ ] Public [ ] Community

Comments/Conditions: Keep septic system 100 ft from well


Comments/Conditions: SEPTIC TANK WITH MARKER INSTALLED USING A "TUFTITE" FILTER

Scale 1" = 50 ft

INITIAL SITE SKETCH

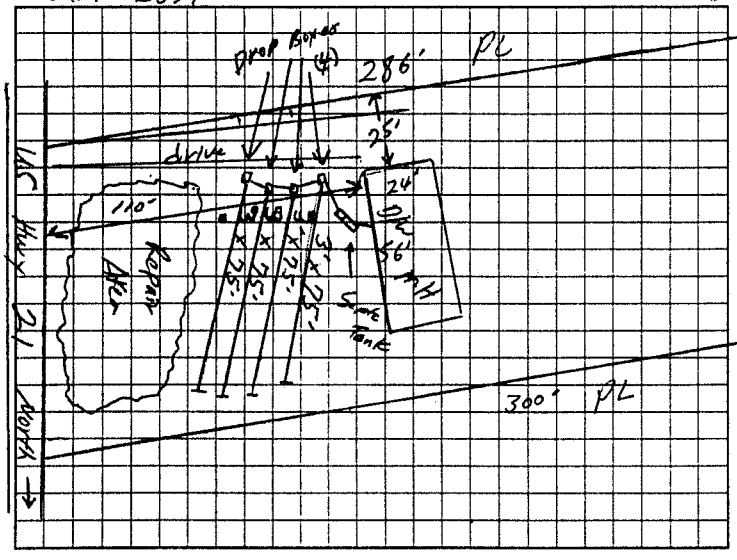

AS BUILT SKETCH

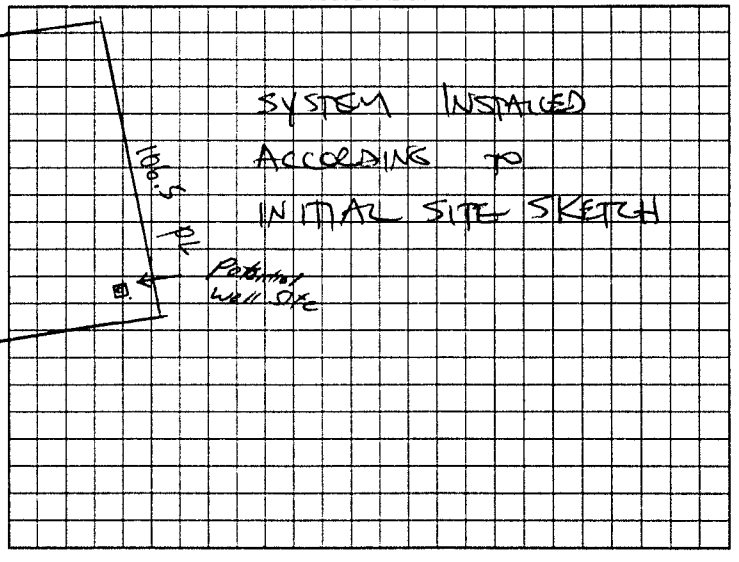

Permit can be suspended or revoked if any false information is supplied toward securing the permit/any unauthorized changes are made to the site/any unauthorized changes are made in the installation of the system. Improvement Permit with plat valid without expiration. Improvement Permit with site plan valid for sixty months. Authorization to Construct is valid for a period equal to that of Improvement Permit – not to exceed sixty months

Signed: ____ date 7-22-02 Installed by: A-1 BACKHOE

Improvement Permit by: William G Johnson date 7/16/02 Operation Permit by: STEVE HEDRICK date 11-25-02

Authorization to Construct by: William G Johnson date 7/16/02 Existing System Inspection by: ____ date ____

HEALTH DEPT. COPY: WHITE OWNER COPY (FINAL): YELLOW OWNER COPY (INITIAL): PINK