IREDELL COUNTY HEALTH DEPARTMENT

STATESVILLE 704-878-5305 (CD) MOORESVILLE 704-664-5281

IMPROVEMENT PERMIT / AUTHORIZATION TO CONSTRUCT / OPERATION PERMIT / EXISTING SYSTEM INSPECTION

(CD)

PERMIT# 106078 PIN# 4873 - 99 - 5125 . 5 DATE 5-9-02

OWNER OR CONTRACTOR BOB HILL PHONE: Business 910 704-528-7120 Home

ADDRESS 4913 HARMONY HWY, HARMONY, NC 28634

LOCATION US 21 NORTH 7.5 MILES NORTH OF HARMONY ON LEFT AT BOX #4913

SUBDIVISION GRANTS GLEN BLOCK / SECTION LOT 5 LOT AREA 0.779 ACRES SITE CLASS PS DESIGN FLOW 360 L.T.A.R. 0.40 GPD/FT²

Septic Tank: 1000 Gallons; STB 1012 Date 12-23-01
Pump Tank: Gallons; PT Date
Pump Make: Model Serial No
Nitrification Field: No Fields 1 Square Feet 900 Linear Feet 300
No Lines FOUR Trench Width 36" Max Trench Bottom Depth 36" Gravel Depth 12"

☑ New System ☐ Repair System Type: I (II) III IV V VI
System Description: CONVENTIONAL GRAVITY
Repair System Description: CONV., PUMP
Maintenance Agreement Required: ☐ Yes ☑ No

☐ House/Mod. Home ☑ Mobile Home ☐ Business ☐ Other
No. Bedrooms 3 No. Bathrooms 2 No. Employees


☑ Slab ☐ Crawl Space ☐ Basement w/plumbing ☐ Basement wo/plumbing

Water Supply: ☑ Individual ☐ Public ☐ Community
WELL


Comments/Conditions: KEEP SYSTEM MINIMUM 100 FEET FROM WELL

Comments/Conditions: SEPTIC TANK INSTALLED WITH MARKER, USING "POLY LOK" FILTER

INITIAL SITE SKETCH

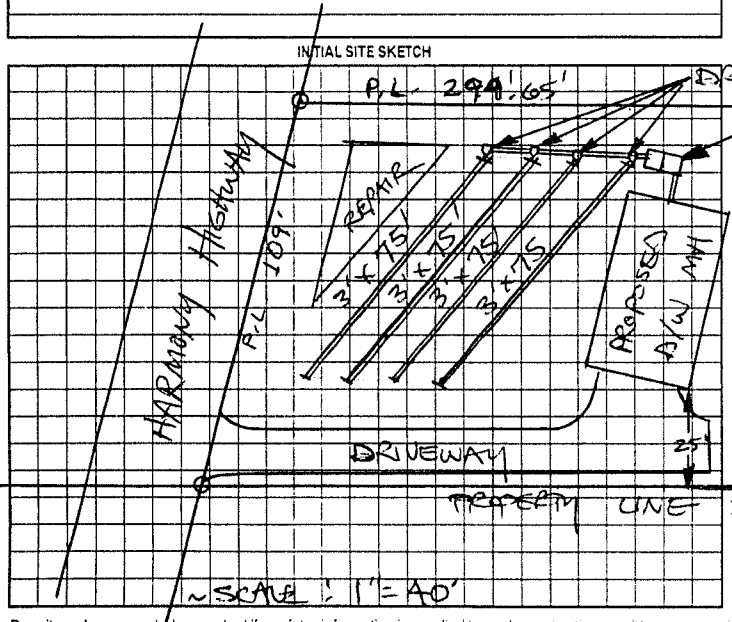

AS BUILT SKETCH

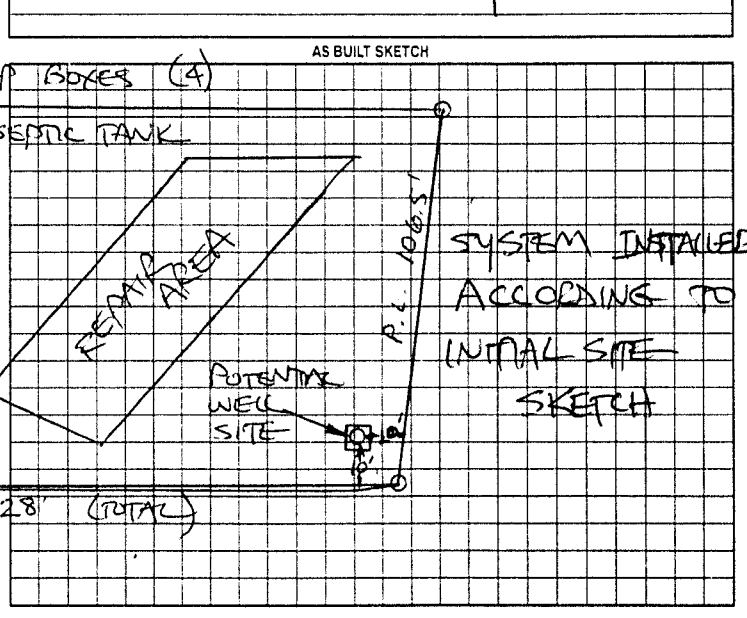

Permit can be suspended or revoked if any false information is supplied toward securing the permit/any unauthorized changes are made to the site/any unauthorized changes are made in the installation of the system. Improvement Permit with plat valid without expiration. Improvement Permit with site plan valid for sixty months. Authorization to Construct is valid for a period equal to that of Improvement Permit – not to exceed sixty months.

Signed: [signature] date 5-9-02 Installed by A-1 BACKHOE

Improvement Permit by: STEVE HEDRICK date 5-9-02 Operation Permit by: STEVE HEDRICK date 5-16-02

Authorization to Construct by: STEVE HEDRICK date 5-9-02 Existing System Inspection by: date

HEALTH DEPT COPY: WHITE OWNER COPY (FINAL): YELLOW OWNER COPY (INITIAL): PINK