IREDELL COUNTY HEALTH DEPARTMENT

STATESVILLE 704-878-5305 MOORESVILLE 704-664-5281

IMPROVEMENT PERMIT / AUTHORIZATION TO CONSTRUCT / OPERATION PERMIT / EXISTING SYSTEM INSPECTION

PERMIT# 134686 PIN# 4874-12-9969 DATE 5-2-06

OWNER OR APPLICANT HECTOR & Kristine RUIZ PHONE: Business [redacted] 336-466-1438 Home

ADDRESS 3924 BARNARDS MILL RD Harmonville NC 27020

LOCATION 21 N (L) BARNARDS MILL 1.5 miles on RT ACCESS FROM DASH RD

SUBDIVISION BLOCK / SECTION LOT 2 LOT AREA .87AC SITE CLASS PS DESIGN FLOW 360 L.T.A.R. .35

Septic Tank: 1000 Gallons; STB 1060 Date 9-23-05
Pump Tank: Gallons; PT Date
Pump Make: Model Serial No.
Nitrification Field: No Fields 1 Square Feet 1028 Linear Feet 344'
No Lines 4x86' Trench Width 36" Max Trench Bottom Depth 36" Gravel Depth 12"

☒ New System ☐ Repair ☐ Expansion System Type: I (II) III IV V VI
System Description: 60AW CONV
Repair System Description: LP 50% / 25% REDUCT
Maintenance Agreement Required: ☐ Yes ☒ No

☐ House/Mod. Home No. Bedrooms 3
☒ Mobile Home No. Persons 6
☐ Business No. Employees
☐ Other


Water Supply: ☒ Individual ☐ Public ☐ Community

☒ Gravity ☐ Pressure ☐ Slab ☒ Crawl Space ☐ Basement w/plumbing ☐ Basement wo/plumbing


Comments/Conditions: (1) INSTALL LINES AT 36" TRENCH BOTTOM DEPTH (2) AN ALLEPTOO SYSTEM MAY BE USED (3) INSTALL LINES ON CONTOURS (4) SYSTEM SIZED FOR 3 BEDROOMS ONLY PUTTING IN 2 BEDROOMS, NOT TO SCALE

Comments/Conditions: LABEL F. LTR & MARKER

INITIAL SITE SKETCH

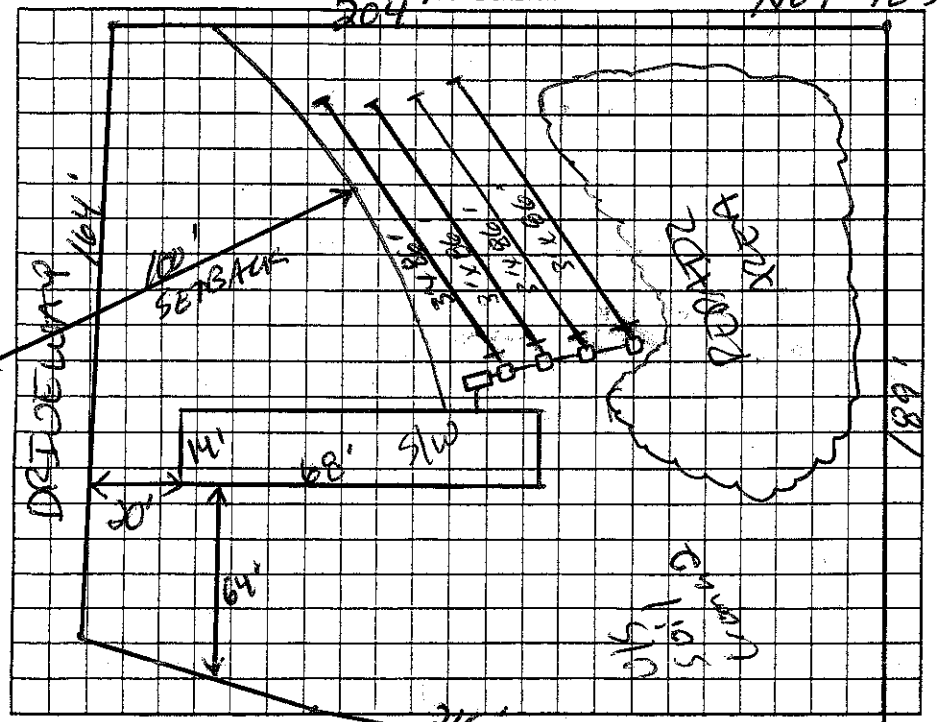

AS BUILT SKETCH

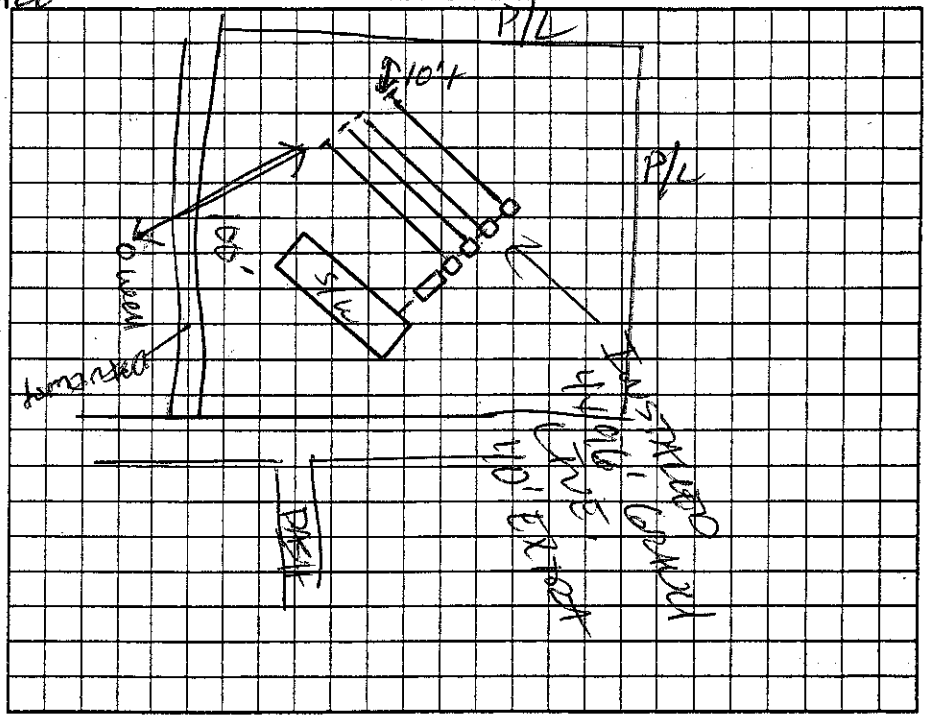

Permit can be suspended or revoked if any false information is supplied toward securing the permit/any unauthorized changes are made to the site/any unauthorized changes are made in the installation of the system. Improvement Permit with plat valid without expiration ☐ Improvement Permit with site plan valid for sixty months ☒ Authorization to Construct is valid for a period equal to that of Improvement Permit – not to exceed sixty months.

Signed: [signature] date 5-2-06 Installed by: Tommy Mixon

Improvement Permit by: [signature] date 5-2-06 Operation Permit by: [signature] date 5-16-06

Authorization to Construct by: [signature] date 5-7-06 Existing System Inspection by: date

HEALTH DEPT. COPY: WHITE OWNER COPY (FINAL): YELLOW OWNER COPY (INITIAL): PINK