IREDELL COUNTY HEALTH DEPARTMENT

STATESVILLE 704-878-5305 MOORESVILLE 704-664-5281

IMPROVEMENT PERMIT / AUTHORIZATION TO CONSTRUCT / OPERATION PERMIT / EXISTING SYSTEM INSPECTION

PERMIT# 072061 PIN#

OWNER OR CONTRACTOR CHARLES STUTTS DATE 5-4-98

ADDRESS 8328 MOHAN CT. JACKSONVILLE, FL 32221 PHONE: Business (904) 378-0146 Home (704) 547-0762

LOCATION US 21 N, TL BARNARD MILL ROAD, 1.5 MILES ON LEFT

SUBDIVISION BLOCK / SECTION LOT LOT AREA 31 ACRES SITE CLASS. PS DESIGN FLOW 240 L.T.A.R. 0.25 GPD/FT²

Septic Tank: 1000 Gallons; STB 1012 Date 2-27-98
Pump Tank: Gallons; PT Date
Pump Make: Model Serial No.
Nitrification Field: No Fields 1 Square Feet 960 Linear Feet 320
No Lines THREE Trench Width 36" Max Trench Bottom Depth 36" Gravel Depth 12"

☒ New System ☐ Repair System Type: I, ☒ II, III, IV, V, VI
System Description: CONVENTIONAL GRAVITY
Repair System Description: CHAMBER PUMP
Maintenance Agreement Required: ☐ Yes ☒ No


☐ House/Mod. Home ☒ Mobile Home ☐ Business ☐ Other
No. Bedrooms 2 No. Bathrooms 2 No. Employees
☐ Slab ☒ Crawl Space ☐ Basement w/plumbing ☐ Basement wo/plumbing

Water Supply: ☒ Individual ☐ Public ☐ Community WELL


Comments:/Conditions: ① KEEP SYSTEM MINIMUM 100' FROM WELL ② INSTALL LINES AS FLAGGED ON SITE ON CONTOUR.

Comments:/Conditions:

INITIAL SITE SKETCH SCALE: ~ 1" = 50'

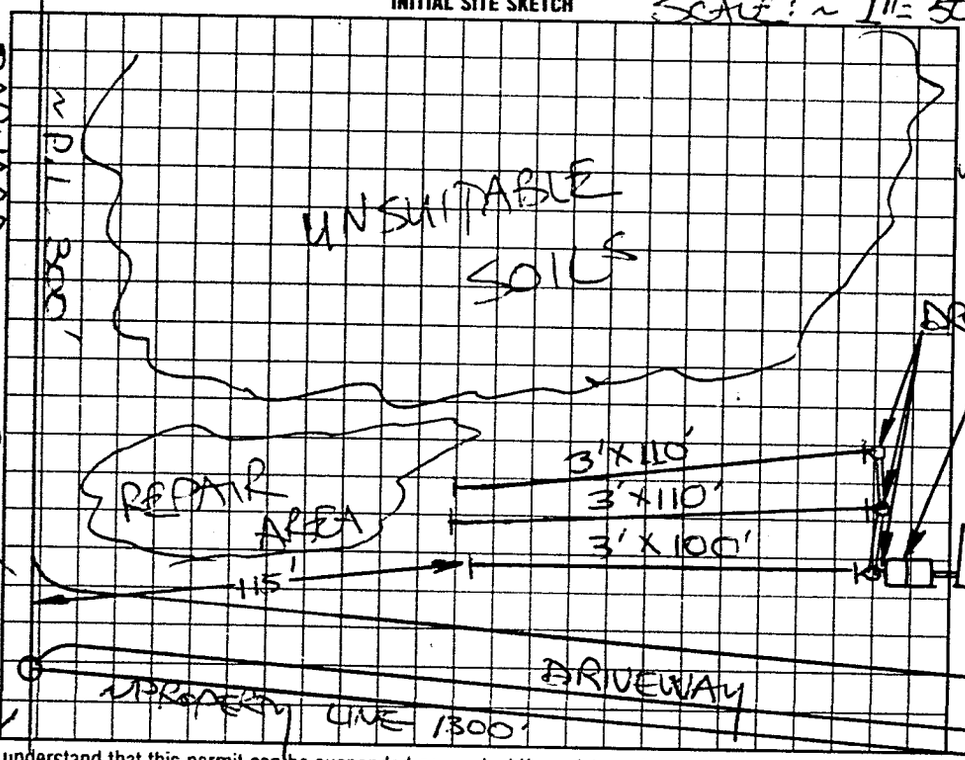

AS BUILT SKETCH

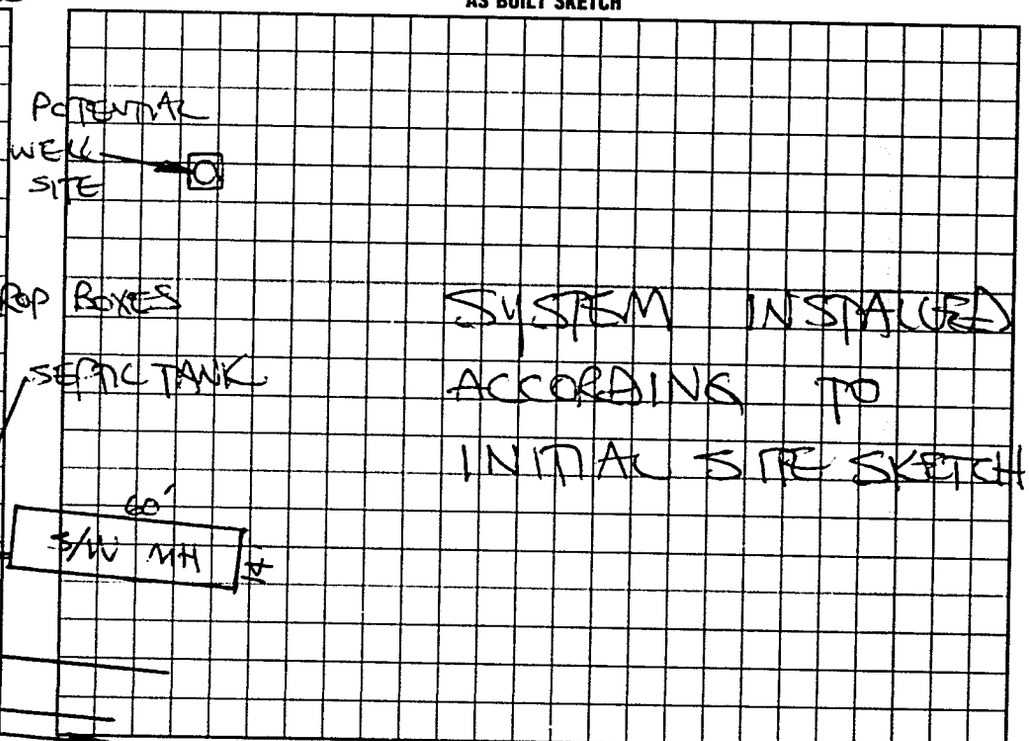

I understand that this permit can be suspended or revoked if any false information is supplied toward securing the permit/any unauthorized changes are made to the site/any unauthorized changes are made in the installation of the system. Improvement Permit with plat valid without expiration. Improvement Permit with site plan valid for sixty months. Authorization to Construct is valid for a period equal to that of Improvement Permit – not to exceed sixty months.

Signed: [signature] date 5-4-98

Improvement Permit by: STEVE HODRICK date 5-4-98

Authorization to Construct by: STEVE HODRICK date 5-4-98

Installed by: KENNY MADISON

Operation Permit by: STEVE HODRICK date 5-6-98

Existing System Inspection by: date

HEALTH DEPT. COPY WHITE INSPECTION COPY (FINAL) GREEN OWNER COPY (FINAL) YELLOW INSPECTION COPY (INITIAL) PINK OWNER COPY (INITIAL) GOLD