IREDELL COUNTY HEALTH DEPARTMENT

STATESVILLE 704-878-5305 MOORESVILLE 704-664-5281

IMPROVEMENT PERMIT / AUTHORIZATION TO CONSTRUCT / OPERATION PERMIT / EXISTING SYSTEM INSPECTION

PERMIT# 077847 PIN# 4874 50 7389 (PT) DATE 12-8-98

OWNER OR CONTRACTOR RAY ALLEN ELLER, JR PHONE: Business Home 660-5327

ADDRESS 1682 CHARLOTTE HIGHWAY MOORESVILLE, NC 28115

LOCATION US 21 N, TL BARNARD MILL ROAD TL ELEANOR LANE, 0.5 MILE ON RIGHT

SUBDIVISION BLOCK / SECTION LOT LOT AREA 13.78 ACRES SITE CLASS. PS DESIGN FLOW 360 L.T.A.R. 0.5 GPD/FT²

Septic Tank: 1000 Gallons; STB 620 Date 11-19-98
Pump Tank: Gallons; PT Date
Pump Make: Model Serial No.
Nitrification Field: No Fields 1 Square Feet 720 Linear Feet 240
No Lines THREE Trench Width 36" Max Trench Bottom Depth 36" Gravel Depth 12"

☑ New System ☐ Repair System Type: I II III IV V VI
System Description: CONVENTIONAL GRAVITY
Repair System Description: CONV. GRAVITY
Maintenance Agreement Required: ☐ Yes ☑ No
☐ Slab ☑ Crawl Space ☐ Basement w/plumbing ☐ Basement wo/plumbing

☑ House/Mod. Home ☐ Mobile Home ☐ Business ☐ Other
No. Bedrooms 3 No. Bathrooms 2 No. Employees


Water Supply: ☑ Individual ☐ Public ☐ Community
WELL

Comments/Conditions: KEEP SYSTEM MINIMUM 100 FEET FROM SYSTEM

Comments/Conditions:


SCALE: 1" = 40'

INITIAL SITE SKETCH

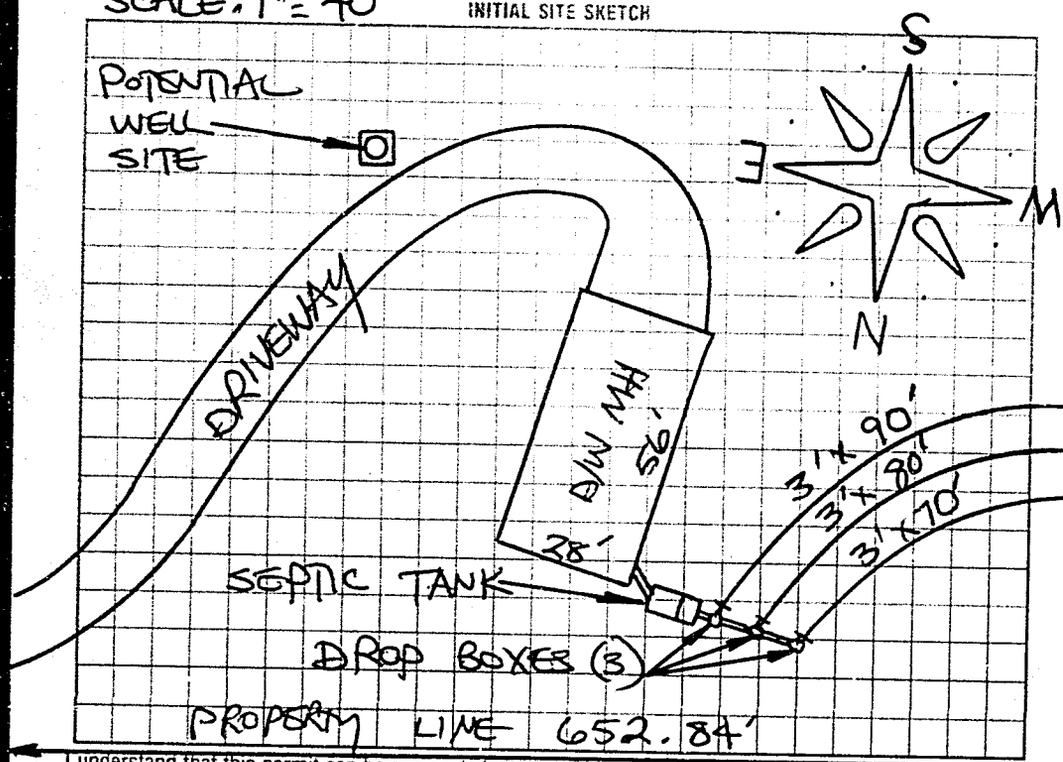

AS BUILT SKETCH

SYSTEM INSTALLED ACCORDING TO INITIAL SITE SKETCH

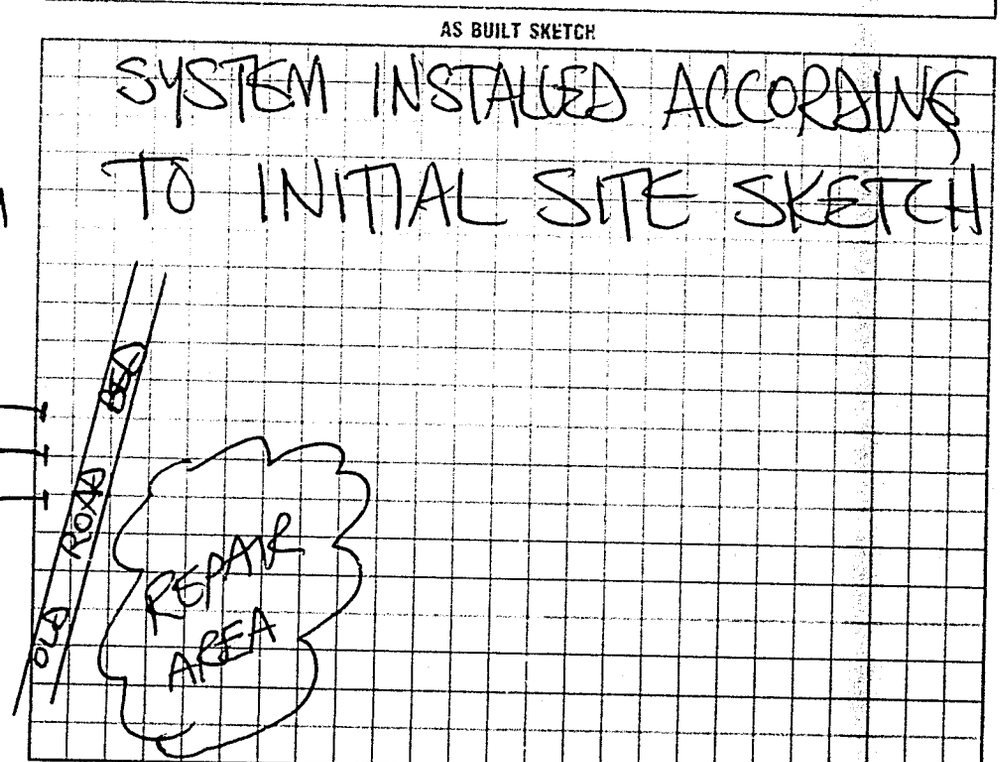

I understand that this permit can be suspended or revoked if any false information is supplied toward securing the permit/any unauthorized changes are made to the site/any unauthorized changes are made in the installation of the system. Improvement Permit with plat valid without expiration. Improvement Permit with site plan valid for sixty months. Authorization to Construct is valid for a period equal to that of Improvement Permit – not to exceed sixty months.

Signed: Ray Allen Eller date 12-8-98

Improvement Permit by: STEVE HEDRICK date 12-8-98

Authorization to Construct by: STEVE HEDRICK date 12-8-98

Installed by: TOMMY NIXON

Operation Permit by: STEVE HEDRICK date 12-18-98

Existing System Inspection by: date

HEALTH DEPT COPY: WHITE INSPECTION COPY (FINAL) GREEN OWNER COPY (FINAL) YELLOW INSPECTION COPY (INITIAL) PINK OWNER COPY (INITIAL) GOLD