IREDELL COUNTY HEALTH DEPARTMENT

STATESVILLE 704-878-5305 MOORESVILLE 704-664-5281

IMPROVEMENT PERMIT / AUTHORIZATION TO CONSTRUCT / OPERATION PERMIT / EXISTING SYSTEM INSPECTION

PERMIT# 142035 PIN# 4874525490 7285 DATE 1 May 07

OWNER OR APPLICANT Millard Ryder Corbin PHONE: Business 704-528-4083 Home

ADDRESS 347 Perry RD Troutman NC 28166

LOCATION 21 N to Barnard RD 1 mile on left

SUBDIVISION Barnard Mill Estates BLOCK / SECTION LOT 2 LOT AREA 13.241 SITE CLASS. RS DESIGN FLOW 360 L.T.A.R. 3

Septic Tank: 1000 Gallons: STB 1012 Date 11-2-06

Pump Tank: Gallons: PT Date

Pump Make: Model Serial No.

Nitrification Field: No Fields Square Feet 1200 Linear Feet 300

No Lines 4 Trench Width 36" Max Trench Bottom Depth 24" Gravel Depth

☑ New System ☐ Repair ☐ Expansion System Type: I II III IV V VI

System Description: 25% Conv

Repair System Description: 25% pump

Maintenance Agreement Required: ☐ Yes ☐ No

☐ House/Mod. Home ☐ Mobile Home ☐ Business ☐ Other

No. Bedrooms 3 No. Persons No. Employees


Water Supply: ☑ Individual ☐ Public ☐ Community

☐ Gravity ☐ Pressure ☐ Slab ☑ Crawl Space ☐ Basement w/plumbing ☐ Basement wo/plumbing

Comments:/Conditions:

Install as Gravity
Maintain all setbacks

INITIAL SITE SKETCH

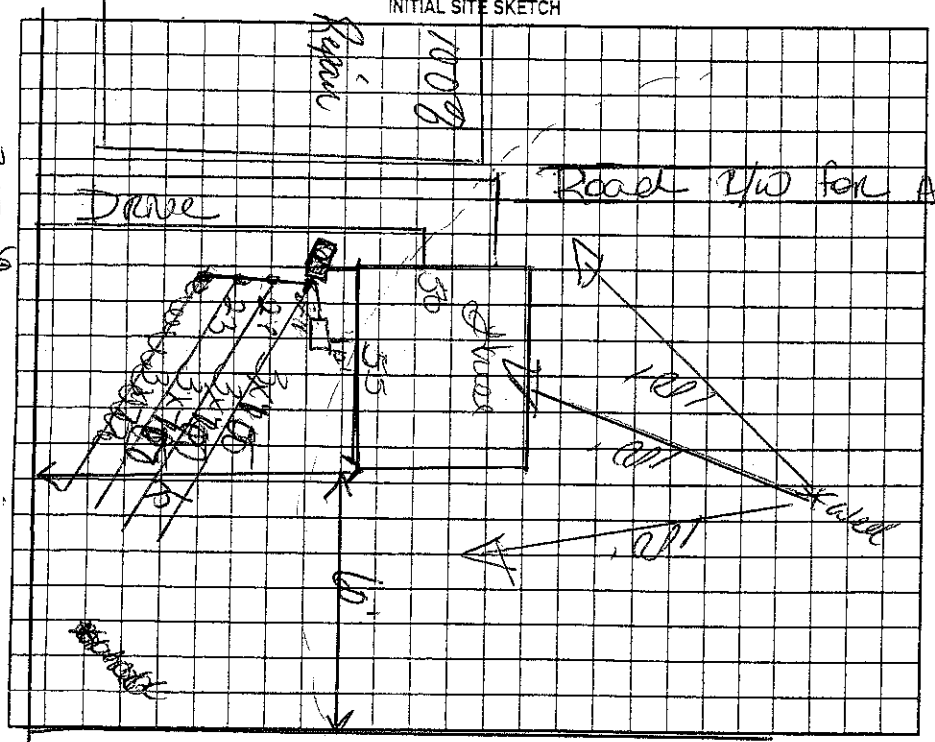


Comments:/Conditions:

NOT to Scale

Yellow Surface Septic tank marker

AS BUILT SKETCH

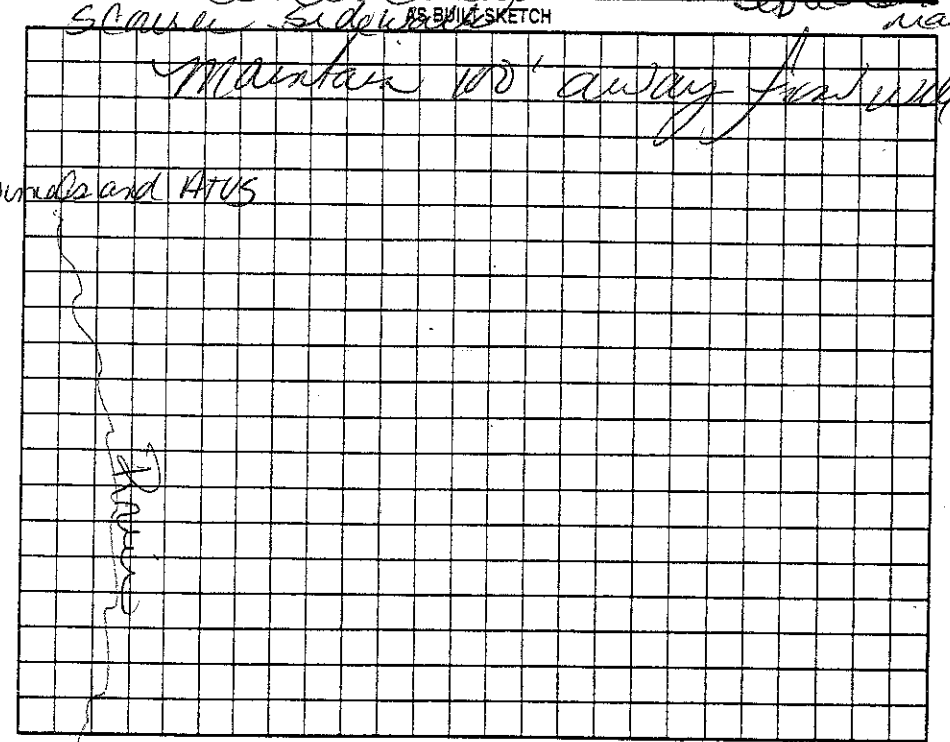

Permit can be suspended or revoked if any false information is supplied toward securing the permit/any unauthorized changes are made to the site/any unauthorized changes are made in the installation of the system. Improvement Permit with plat valid without expiration. ☐ Improvement Permit with site plan valid for sixty months ☑ Authorization to Construct is valid for a period equal to that of Improvement Permit – not to exceed sixty months.

Signed: date 1 May 07 Installed by: Bobby Brown Brown Contr. Inc

Improvement Permit by: date 1 May 07 Operation Permit by: date 01 May 07

Authorization to Construct by: date 1 May 07 Existing System Inspection by: date

HEALTH DEPT. COPY: WHITE OWNER COPY (FINAL): YELLOW OWNER COPY (INITIAL): PINK