IREDELL COUNTY HEALTH DEPARTMENT

STATESVILLE 704-878-5305 MOORESVILLE 704-664-5281

IMPROVEMENT PERMIT / AUTHORIZATION TO CONSTRUCT / OPERATION PERMIT / EXISTING SYSTEM INSPECTION

PERMIT # 158562 PIN # 4874-90-8373 DATE 21 October 09

OWNER or APPLICANT Kevin & Michelle Wooten PHONE: Business (704) 878-3922 Home:

OWNER or APPLICANT ADDRESS 4956 Harmony Hwy

LOCATION / DIRECTIONS Hwy 21 N Concrete post Caution light on Rt.


SUBDIVISION BLOCK / SECTION LOT # LOT AREA 0.7 Ac. DESIGN FLOW 360 gpd L.T.A.R. 0.5 sq ft/gpd

Septic Tank	Exist.	Gallons: STB		Date	☐ New System ☐ Repair ☐ Expansion System Type I (II) III IV V VI	☑ Residence	No. Bedrooms 3	Water Supply
Pump Tank		Gallons: P T		Date	System Description: Exist. Conv.	☐ Business	No. Persons	☑ Private
Pump Make		Model		Serial #	Repair System Description:	☑ Other	No. Employees	☐ Public
Nitrification Field	No Fields Exist.	No. Lines		Linear Feet	Maintenance Agreement Required ☐ YES ☑ NO	☐ Slab	☑ Crawl Space	☐ Community
Trench Width		Max. Trench Bottom Depth		Gravel Depth	☑ GRAVITY ☐ PRESSURE	☐ Basement w/plumbing	☐ Basement w/o plumbing	


Comments / Conditions

Comments / Conditions

INITIAL SITE SKETCH

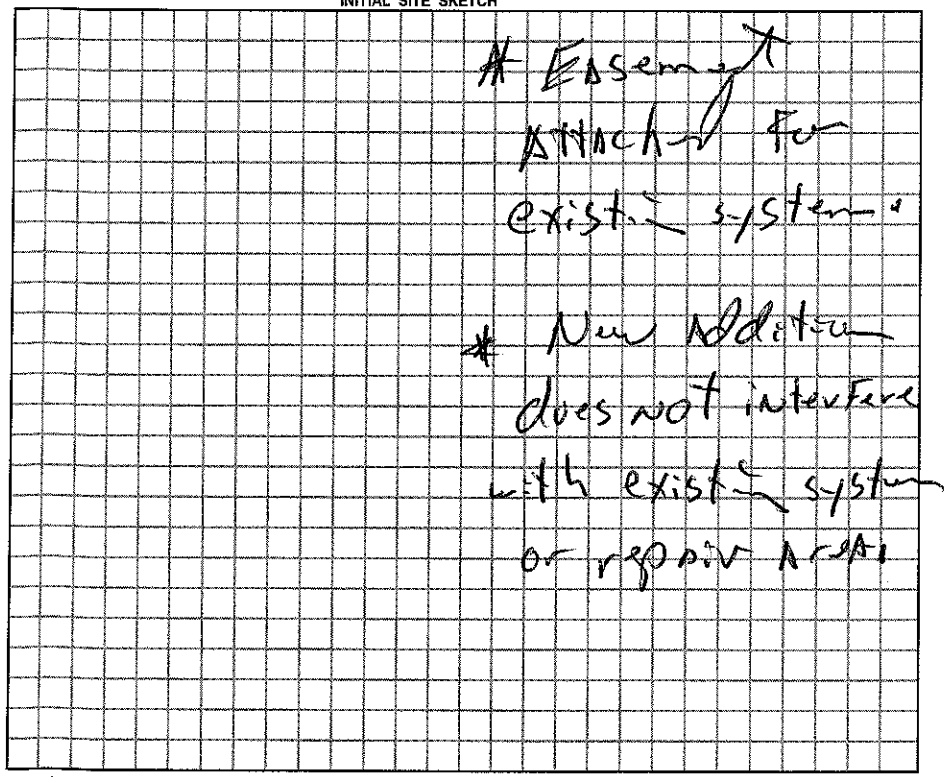

AS BUILT SKETCH

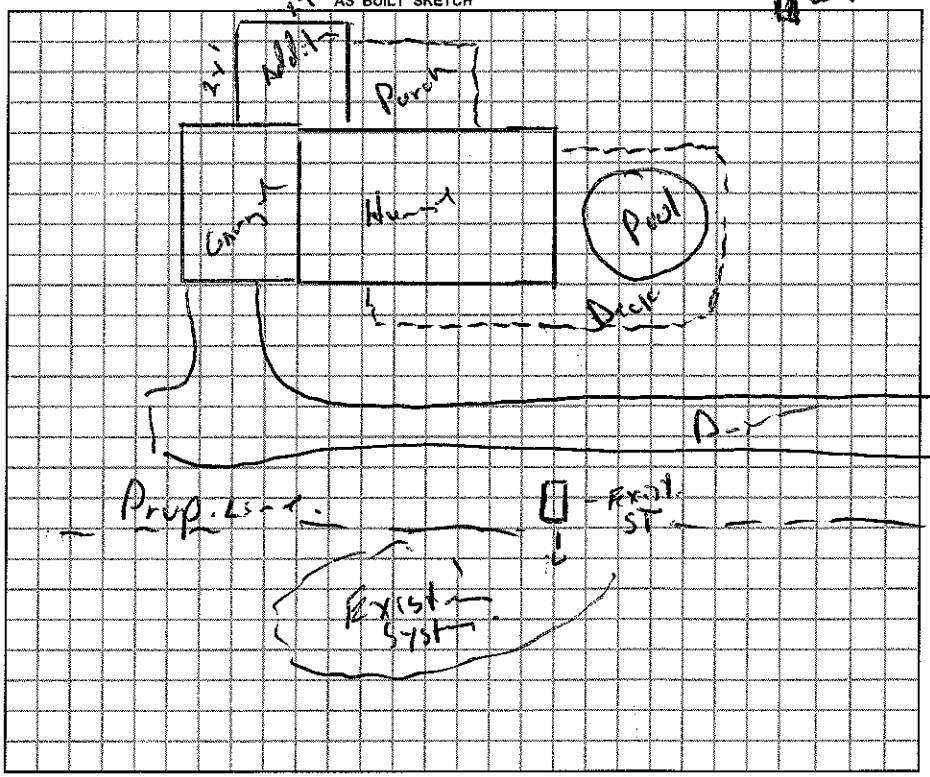

Permit can be suspended or revoked if any false information is supplied toward securing the permit / any unauthorized changes are made to the site / any unauthorized changes are made in the installation of the system.

☐ *IMPROVEMENT PERMIT w / plat valid without expiration.* ☐ *IMPROVEMENT PERMIT w / site plan valid for 60 mos.* ☐ *AUTHORIZATION TO CONSTRUCT valid for period equal to IMPROVEMENT PERMIT-not to exceed 60 mo.*

Owner / Applicant Signature: Date 10-22-09

Improvement Permit by: Date

Authorization to Construct by: Date

YOU SHOULD CONTACT A LOCATOR SERVICE PRIOR TO ANY EXCAVATION.

Installed by:

Operation Permit by: Date:

Existing System Inspected by: , R.S. Date: 21 Oct. 09

WHITE COPY Environmental Health YELLOW COPY (Final) Owner / Applicant PINK COPY (Initial) Owner / Applicant