ICHD - ENVIRONMENTAL HEALTH DIVISION

Statesville Office (704) 878-5305 | Mooresville Office (704) 660-3625 | PERMIT # AP 318624

SEPTIC: IMPROVEMENT PERMIT / AUTHORIZATION TO CONSTRUCT / OPERATION PERMIT / EXISTING SYSTEM

PIN # 4880 -- 00 -- 1329

APPLICANT/OWNER: Clayton Homes - Justin Cranfill | APPLICANT ADDRESS: 2026 Northside Dr Statesville NC 28625

SITE ADDRESS: 304 Cranfill Rd Harmony NC 28634 | PHONE: 704-873-2547 | ALT. PHONE 704-929-1552

SITE DIRECTIONS: I40E to I77N, Exit 54 to R on US 21N, Ron Mt Bethel Rd, L on Shaw Rd, L on Kinder Rd, L on Cranfill Rd, L to our R | SAP CONTROLLED: [ ] YES [X] NO

SUBDIVISION: William + Lora Cranfill | SECTION: — | LOT # 1 | LOT AREA: 1 acre | DESIGN FLOW: EXISTING | L.T.A.R.: Existing

Septic Tank	(gal)	STB	Date	[ ] New System [ ] Repair [ ] Expansion	System Type: I (II) III IV V VI
Pump Tank	(gal)	PT	Date	System Description:	Existing
Pump Make	Model		Serial #	Repair System Description:	Existing
# Nitrification Fields	# Lines		Linear Ft:	Maintenance Agreement Required:	[ ] YES [X] NO
Trench Width	Trench Bottom Depth(Low side)		Gravel Depth EXISTING	[X] GRAVITY	[ ] PRESSURE


[X] Residence [ ] Business [ ] Other [ ] Slab [X] Crawl Space [ ] Basement w/plumbing [ ] Basement w/o plumbing

No. Bedrooms Existing | No. Persons Existing | No. Employees

Water Supply: [ ] Private [X] Public [ ] Community

Comments / Conditions: No sign of failur during time of inspection
Water line must be 10 off any part of septic

INITIAL SITE SKETCH

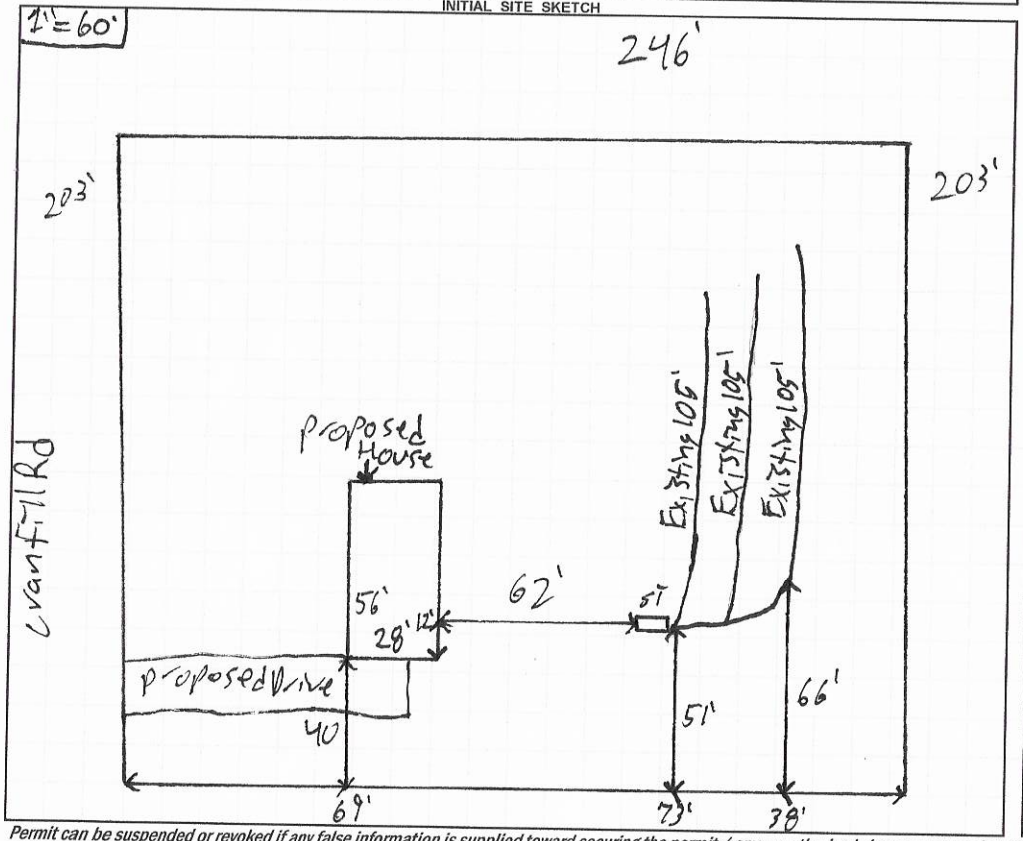

AS BUILT SKETCH

FOR SEPTIC FINAL INSPECTION CALL: 704-664-3703 between 8am-9am the day the inspection is needed. Be sure to speak with an inspector to confirm your time.

Permit can be suspended or revoked if any false information is supplied toward securing the permit / any unauthorized changes are made to the site / any unauthorized changes are made in the installation of the system. **CONTACT A LOCATOR SERVICE PRIOR TO ANY EXCAVATION**

[ ] **IMPROVEMENT PERMIT** *with plat valid without expiration.* [ ] **IMPROVEMENT PERMIT** *with site plan valid for 60 mos.* [ ] **AUTHORIZATION TO CONSTRUCT** *valid for period equal to IMPROVEMENT PERMIT--not to exceed 60 mo.*

Owner / Applicant Signature: [signature] Date: 8/11/21

IMPROVEMENT PERMIT by: Date:

AUTHORIZATION TO CONSTRUCT by: Date:

Installed by:

OPERATION PERMIT by: Date:

Existing System Inspected by: Patrick J Boyle III Date: 8/4/2021

FOR SEPTIC FINAL INSPECTION: CALL 704-664-3703 between 8am-9am the day the inspection is needed.

RECEIVED JUN 10 2021

APPLICATION MUST BE FILLED OUT COMPLETELY & BE LEGIBLE
OR IT WILL NOT BE PROCESSED

Iredell County Health Department – Environmental Health Division

PAGE 1: *APPLICATION FORM* AP-318624 $250.00

Application For: ( ) New Well Permit ( ) Well Repair Permit ( ) Well Abandonment
( ) Septic Improvement Permit ( ) Authorization to Construct (X) Existing System Inspection ( ) Septic System Repair

THE ABOVE PERMIT DOCUMENTS WILL BECOME INVALID IF INFORMATION PROVIDED ON THIS APPLICATION IS FALSIFIED OR CHANGED, OR IF THE SITE IS ALTERED. THE IMPROVEMENT PERMIT IS VALID FOR EITHER 60 MONTHS OR WITHOUT EXPIRATION DEPENDING UPON DOCUMENTATION SUBMITTED. APPLICATION WITH SITE PLAN 60 MONTHS, APPLICATION WITH COMPLETE, SCALED PLAT WITHOUT EXPIRATION. SEE 15A NCAC 18A .1937(f) FOR DETAILS.

Page 2: *Site Plan Worksheet* form MUST accompany this application

The following optional attachments may also be submitted: ( ) Survey Plat, scaled no more than 1 inch = 60 feet
Place an (X) beside whichever is submitted if applicable (X) Custom Site Plan, scaled no more than 1 inch = 60 feet

Applicant Information: (PRINT CLEARLY)

Applicant Name: CLAYTON HOMES STATESVILLE Address: 2046 NORTHSIDE DR STATESVILLE Zip: _____
Applicant Email: adam.carstens@clayhomes.com Phone: 704 873 2547 Alt. Phone: 704 929 1512 adam
Owner Name: WILLIAM CRANFILL Address: _____ Zip: _____
Owner Email: _____ Phone: 704 929 1503 Alt. Phone: _____

Property Information:

Street Address: 304 CRANFILL RD HARMONY
Subdivision Name: — Section/Phase: — Lot Number: —
Driving Directions: _____

Site Development Information: *(check or complete ALL that apply*

(X) New Single Family Residence — Maximum Number of Bedrooms: 3 — (X) Crawl Space Foundation
( ) New Multi-Family Residence — Maximum Number of Occupants: 2 — ( ) Concrete Slab Foundation
( ) Accessory Building — ( ) Swimming Pool — ( ) Basement with Plumbing
( ) Bedroom(s) Addition — ( ) Other Addition/Structure: _____ — ( ) Basement without Plumbing
( ) Repair to failing septic system ___ Tank ___ Drain lines Describe Problem: _____
Non-Residential Site Development: Type of Business: _____
Square Footage of Building: _____ Max. Number of Employees: _____ Max. Number of Seats/Beds/Other: _____

Water Supply: ( ) Replacement Well – Reason: _____
( ) Multi-connection Well Number of Houses: _____ Number of Persons: _____
( ) New Well (X) ~~Existing Well~~ ( ) Community Well ( ) City Water (X) Other Public Water COUNTY

Desired Septic System Type: *(you may rank in order of preference)* Year existing system installed: _____
( ) No Preference ( ) Alternative ( ) Conventional ( ) Innovative ( ) Modified Conventional ( ) Other: _____

Please answer the following to the best of your ability:
( ) Yes (X) No Does the site contain any jurisdictional wetlands?
( ) Yes (X) No Is any non-domestic sewage (i.e. industrial) to be generated?
( ) Yes (X) No Is the site subject to approval by any other public agency?

I have read this application and certify that the information provided herein is true, complete, and correct. Authorized county and state officials are granted right of entry to conduct necessary inspections to determine compliance with applicable laws and rules. I understand that I am solely responsible for the proper identification and labeling of all property lines and corners and making the site accessible so that a complete site evaluation can be performed.

Signature: CLAYTON HOMES STATESVILLE 6/4/21
Property owner or owner's legal representative signature (SIGNATURE REQUIRED) DATE

IREDELL COUNTY DEPARTMENT OF ENVIRONMENTAL HEALTH

DOCUMENTATION TO AUTHORIZE AN OWNER'S LEGAL REPRESENTATIVE

(Check and sign only ONE of the options below)

☐ 1. *** APPLICANT AND OWNER ARE THE SAME. *** *(Sign here)* _____

Applications for permits require the "signature of the owner or owner's legal representative" (15A NCAC 18A .1937). If the owner does not sign the application himself or herself, they can submit any one of the following documents to designate their legal representative: *Power of Attorney; Real Estate Contract; Estate executor; Bankruptcy trustee; Court ordered guardianship* In the absence of the above documentation, the property owner may provide the local health department with documentation that designates a legal representative. A property owner may:
Complete this form to document his or her legal representative, or provide his or her own form that contains the information in this form. If there are multiple property owners, then all property owners must sign the form that designates a legal representative.
By signing a form that designates a legal representative for purposes of 15A NCAC 18A .1937, the property owner authorizes that representative to act on their behalf in matters pertaining to the application and permitting process, including signing or receiving any application, document or permit. The owner retains full responsibility to meet all permit conditions specified by the local health department.



- Application for Improvement Permit (IP) / Authorization to Construct (AC)
- Improvement Permit (IP) / Authorization to Construct (AC)
- Application for soil-site evaluation (new/repair)
- Application/permit for private drinking water well/well abandonment
- Application for Compliance Inspection

I agree to abide by all decisions and/or conditions between the legal representative acting on my behalf and the Iredell County Department of Public Health, Environmental Health Division.

Justin T. Crosby
Signature of Owner(s)

6-7-21
Date

Mooresville - Environmental Health
Fax: 704-662-3239
610 E. Center Avenue, Mooresville, NC 28115


Statesville - Environmental Health
ronda.hart@co.iredell.nc.us
Fax: 704-871-3483
349 N. Center Street, Statesville, NC 28677

IREDELL COUNTY HEALTH DEPARTMENT

ENVIRONMENTAL HEALTH DIVISION

PAGE 2: *SITE PLAN WORKSHEET*

SEE THE "SAMPLE SITE PLAN" BELOW. *INCOMPLETE SITE PLANS WILL BE RETURNED TO YOU FOR COMPLETION AND MAY RESULT IN A DELAY IN THE ISSUANCE OF YOUR SEPTIC SYSTEM PERMIT!!!*

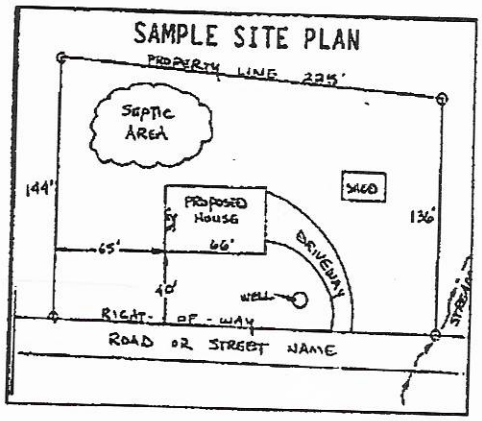

Place an (X) beside each item as you complete the site plan:

( ) Property Line measurements are clearly identified
( ) All proposed structures are indicated
( ) Front and side setbacks from property line
( ) Preferred driveway location and well location
( ) Area you prefer your septic system to be placed
( ) North arrow, or other sufficient indicator of direction

Circle N/A on the following if appropriate:

Location of septic systems and wells within 100' of your property	N/A
Location of easements and rights of ways on your property	N/A
Location of any designated wetlands on the property	N/A

USE THIS SPACE TO DRAW YOUR SITE PLAN

Show: proposed house or business footprint, wells, water lines, patios, pools and decks, and any other item that will occupy space on the site


SEE ATTACHED

Signature: Clayton Hanes STARNES


Property owner or owner's legal representative signature (SIGNATURE REQUIRED)

6/4/21
DATE

* A smaller parcel will be taken out of this * Has County water

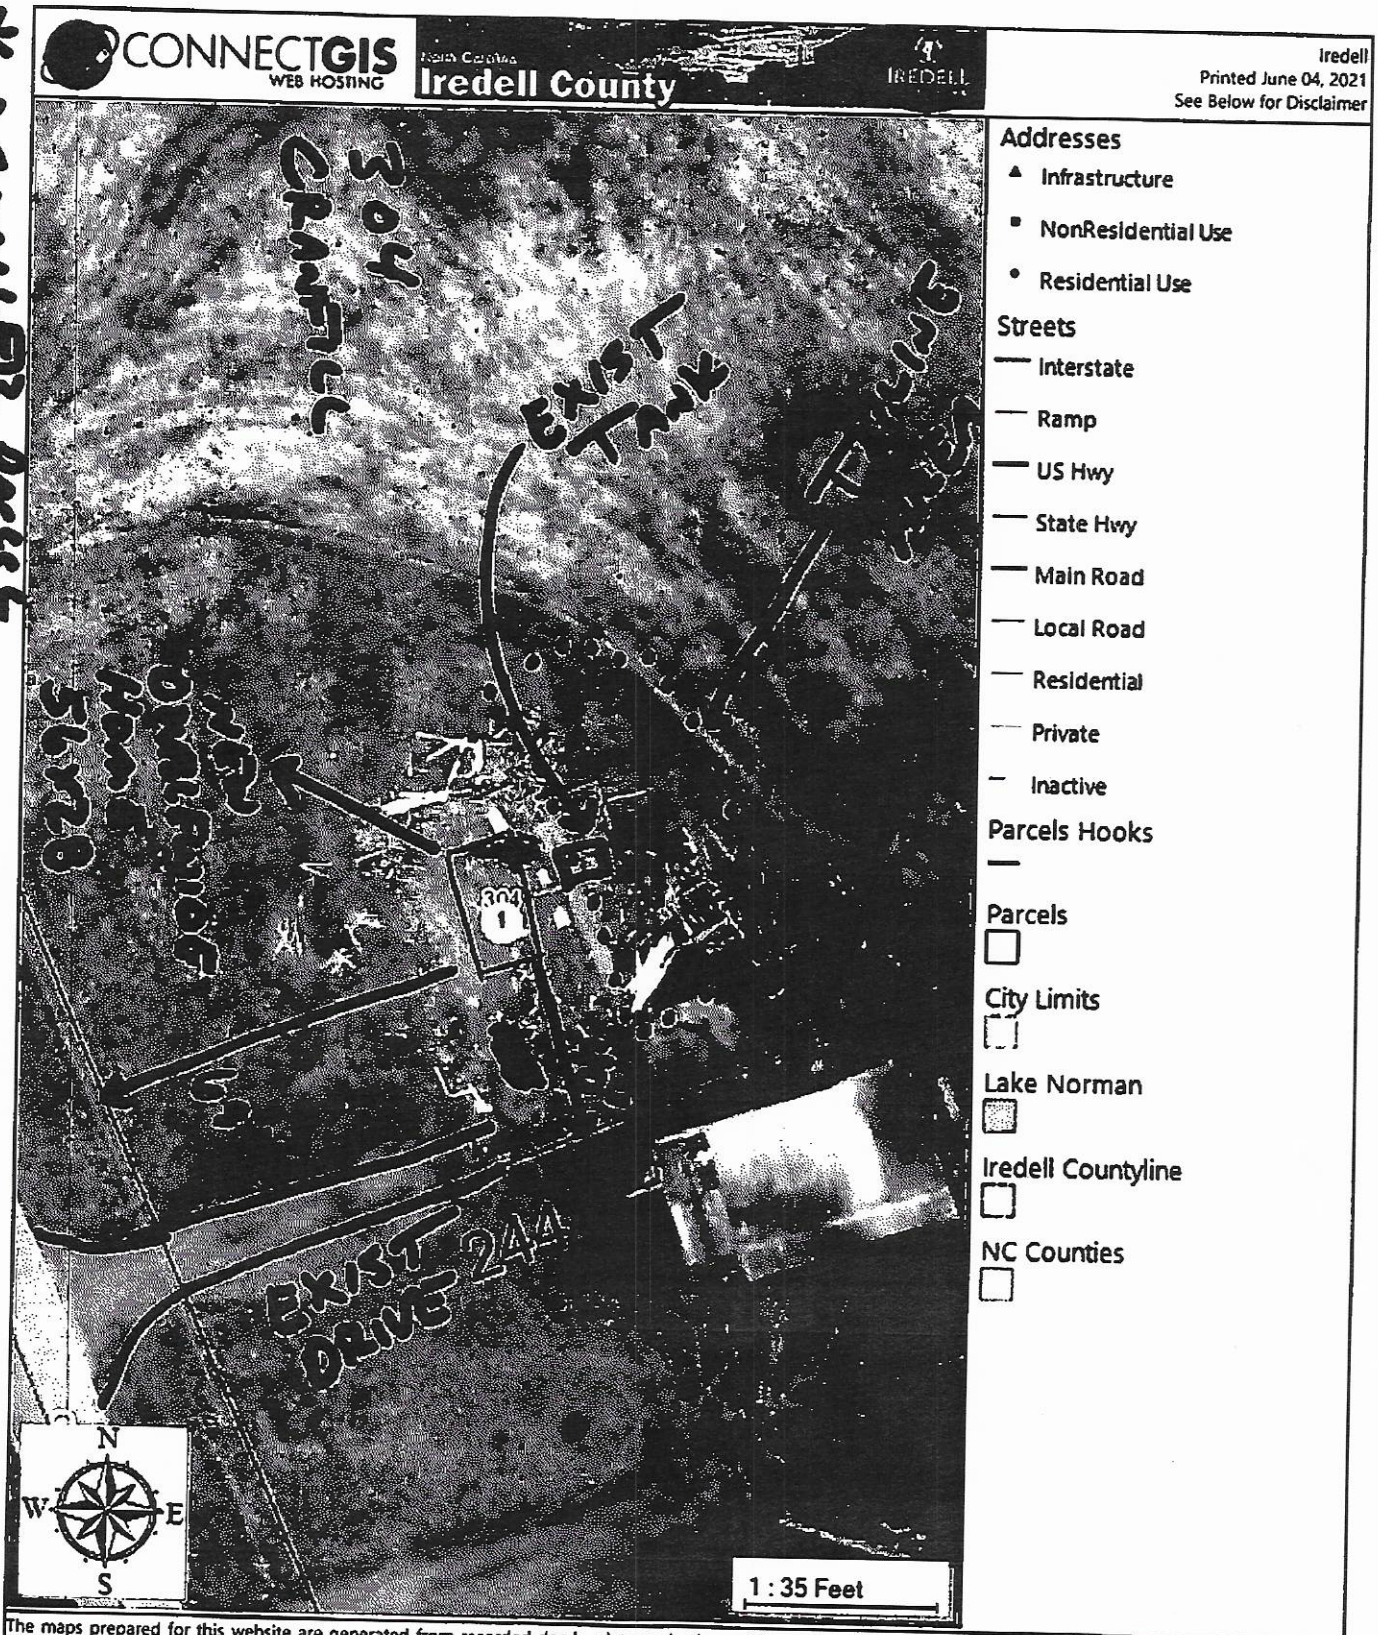

The maps prepared for this website are generated from recorded deeds, plats, and other public records. Users of these maps are hereby notified that the information provided herein should be verified. Iredell County assumes no legal responsibilities for any of the information contained on this site. Users are advised that the use of any of this information is at their own risk. All maps on this site were prepared using a 1000â€™ Grid based upon the North Carolina State Plane Coordinate System from the 1983 North American Datum. The delinquent real property tax overlay is updated monthly. The information presented is not intended to be used or relied upon as official notice of tax liens. For additional information regarding delinquent taxes, contact the Iredell County Tax Collector's Office.

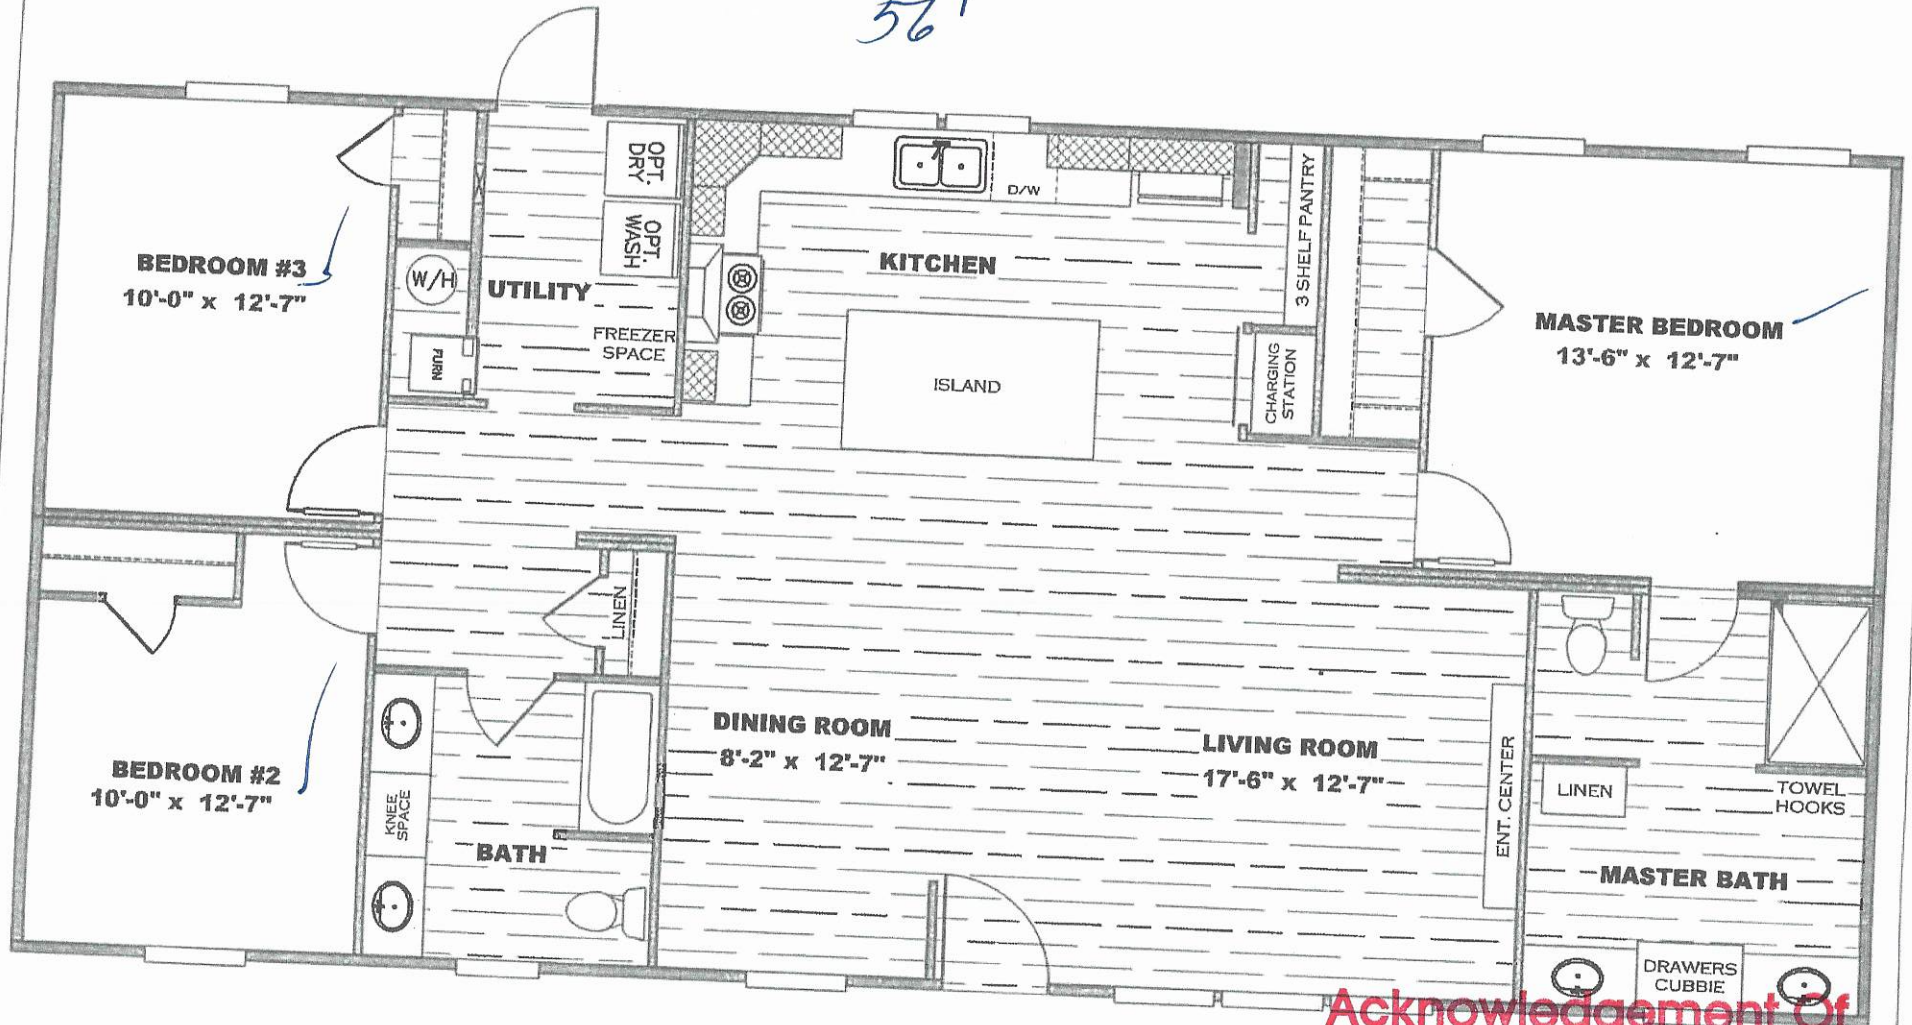

Acknowledgement Of
Plans Submittal ONLY!

Date

Date 8-16-2018

SHEET:							
SL.1	SALES LITERATURE	Clayton - 934 1420 Mountain Rd, Andersonville, TN 37705 PH: 865.494.7800 FAX: 865.494.0243	HILBORN, WERNER, CARTER, AND ASSOCIATES, INC. 1627 SOUTH MYRTLE AVE. CLEARWATER, FL 33756	DRAWING #: 34M178 MODEL #: TRA28564I DATE: 05/09/2018 SCALE: N.T.S.	MODEL: ISLAND BREEZE SERIES: THE M.V.P. PRODUCT DESIGNER: DANIEL C. SHELDON	STD PLAN "CONDITIONED": 1,475 FT² REV. BY: DCS REV. DATE: 06/01/2018	

IREDELL COUNTY · NC

IREDELL COUNTY
PO Box 788
349 North Center St.
Statesville, NC 28677

APPLICATION NUMBER
318624 Issue Date: 06/09/2021

Permit Type: ZONING

Parcel Number	Street Address	Jurisdiction
4880004477.000	304 CRANFILL RD	IREDELL COUNTY

Owner Information	Applicant Information
Name: CRANFILL WILLIAM P+LORA J Address: , Phone:	Name: CLAYTON HOMES OF STATESVILLE Address: 2026 NORTHSIDE DR STATESVILLE, NC 28677 Phone: (704)873-2547

Use Requested	Zone Code
Double-Wide Mobile Home	RA

Lot Acreage	F Setback	B Setback	L Setback	R Setback	Watershed	Flood Zone
0	35	35	15	15	N/A	NO

Remarks

DWMH

REQUIREMENTS FOR ALL MULTI -SECTIONAL MOBILE HOMES Must meet requirement R9 of the LDC. Minimum size of main body is at least 22 feet by 40 feet; Must have standard residential shingles; Minimum of 3/12 roof pitch; Must have continuous masonry underpinning; Must have minimum roof eave and raker projections of 6 inches; Must have a 36 square foot deck or porch at all front entrances; Exterior siding must consist of vinyl or aluminum lap siding, wood, or hardboard, comparable in composition, appearance and durability to residential siding; Must remove towing apparatus; Must face front property line and be no less than 20 degrees from parallel to the front property line. Original mobile home must be removed before Certificate of Occupancy can be approved.

The applicant certifies that there are no deed restrictions, contractual agreements or governmental regulations of any kind that interfere with or prohibit the use of the property or the use for which this permit is requested. The applicant further acknowledges that enforcement of deed restrictions, plat conditions and other contractual agreements will not be undertaken by Iredell County and is the sole responsibility of the affected parties.

_____
Signature of Owner/Contractor


Date: 06/09/2021

Permit Number	318624	TOTAL FEES:	$77.25

3100621

NTI
WS - ND
FL - NO

ZONING DISCLAIMER

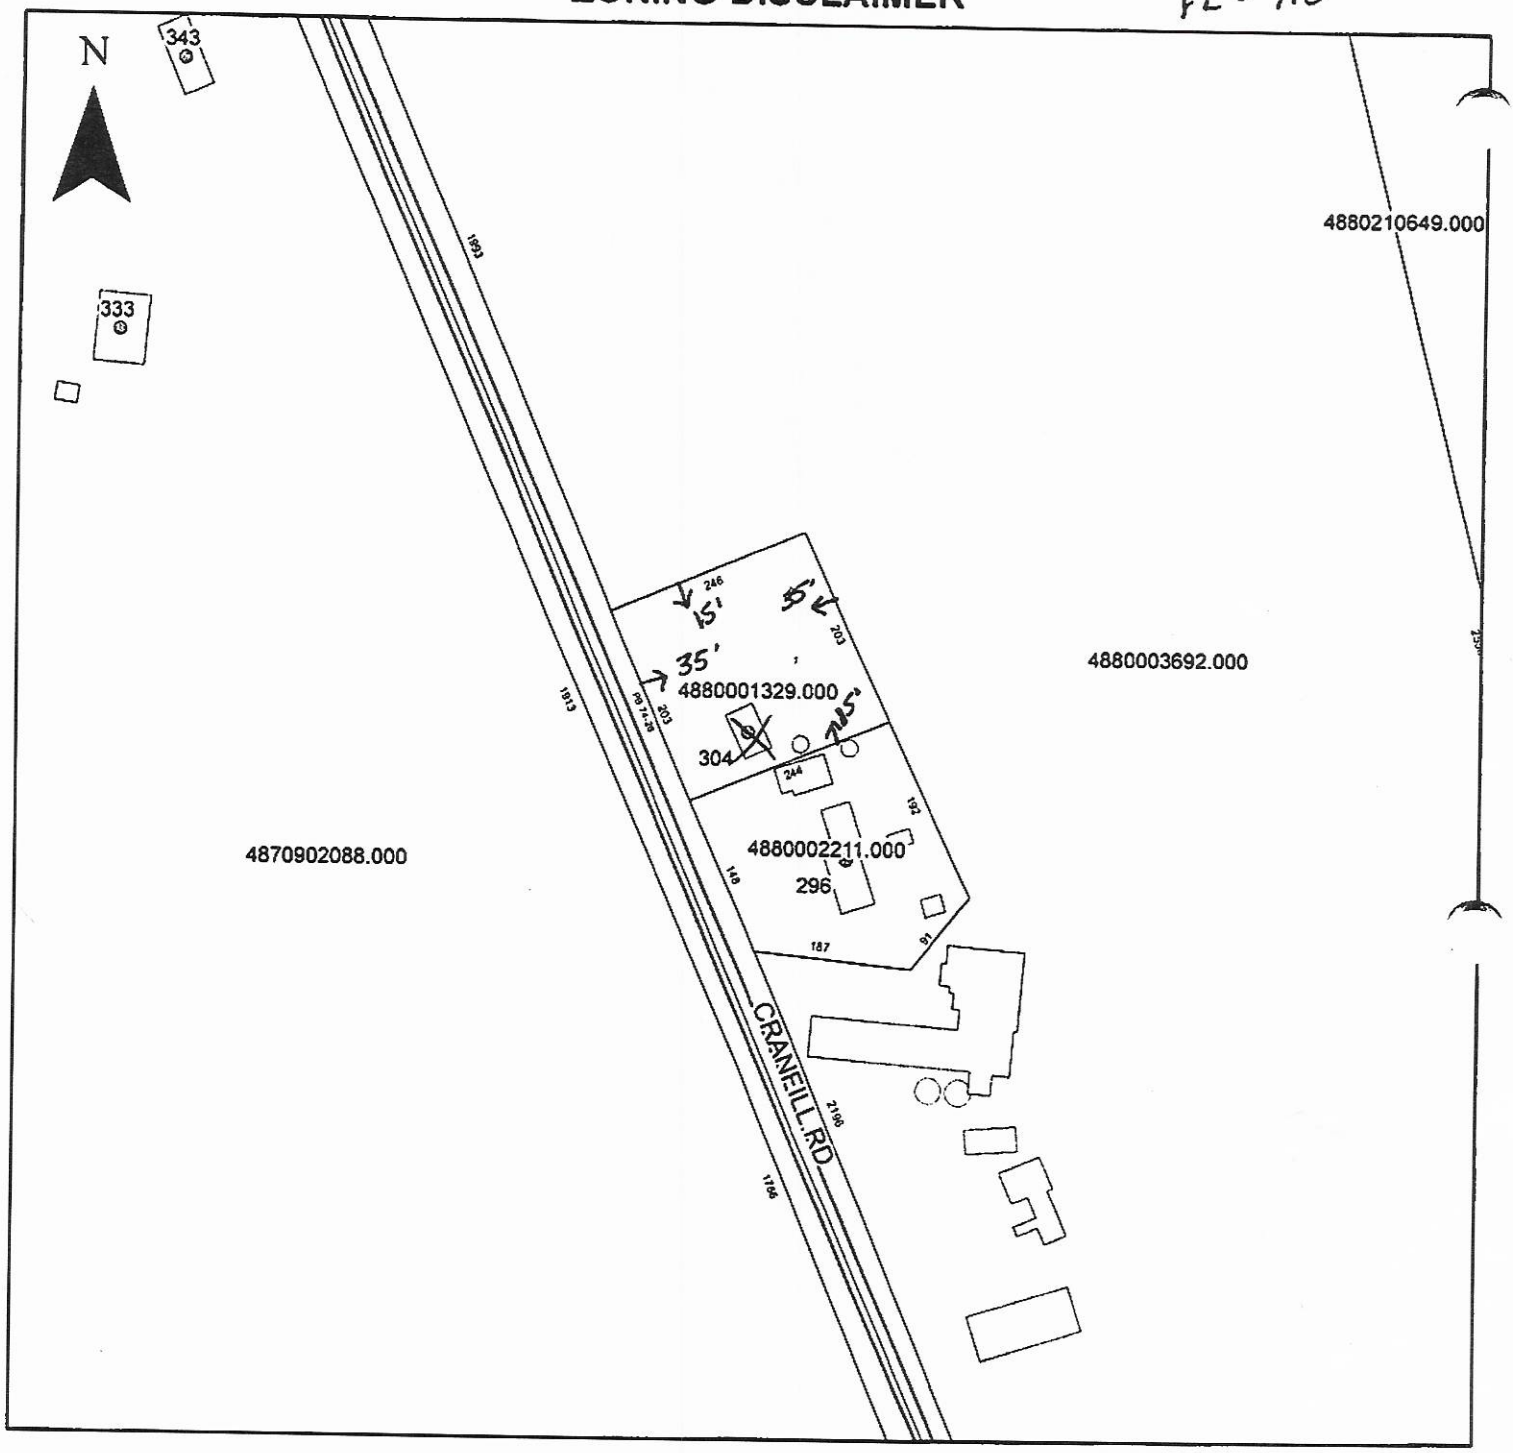

Property Address 304 Cranfill Rd.

The applicant certifies that there are no deed restrictions, contractual agreements or governmental regulations of any kind that interfere with or prohibit the use of the property or the use for which this permit is requested. Applicant further acknowledges that the enforcement of deed restrictions, plat conditions, and other contractual agreements will not be undertaken by Iredell County and is the sole responsibility of the affected parties.

Applicant

6/9/21
Date