IREDELL COUNTY HEALTH DEPARTMENT

STATESVILLE 704-878-5305 MOORESVILLE 704-664-5281

IMPROVEMENT PERMIT / CERTIFICATE OF COMPLETION / OPERATION PERMIT / EXISTING SYSTEM INSPECTION

PROPERTY DESCRIPTION NO. 067378 DATE 6-24-97 TAX MAP NO. 4880 08 3477 Watershed: ☐ Yes ☒ No

OWNER OR CONTRACTOR KAREN GAITHER PHONE: Business Home 546-5147

ADDRESS 149 MAY BERRY ROAD, HARMONY NC 28634

LOCATION US 21 N, TR TOMLINSON AVE, TR REDMON RD, BEAR LEFT AT BOX #179, 0.3 MI ON

SUBDIVISION BLOCK / SECTION LOT LOT AREA 1.0 ACRE SITE CLASS. PS DESIGN FLOW 360 L.T.A.R. 0.40 GPD/FT2

Septic Tank: 1000 Gallons; STB 786 Date 6-23-97

Pump Tank: Gallons; PT Date

Pump Make: Model Serial No.

Nitrification Field: No Fields 1 Square Feet 900 Linear Feet 300

No Lines FOUR Trench Width 36" Max Trench Bottom Depth 36" Gravel Depth 12"

☒ New System ☐ Repair System Type: I, II, III, IV, V, VI

System Description: CONVENTIONAL GRAVITY

Repair System Description: CONV. GRAVITY

Maintenance Agreement Required: ☐ Yes ☒ No

☒ House/Mod. Home No. Bedrooms 3

☐ Mobile Home No. Bathrooms 2

☐ Business No. Employees

☐ Other

☐ Slab ☒ Crawl Space ☐ Basement w/plumbing ☐ Basement wo/plumbing


Water Supply: ☒ Individual ☐ Community ☐ Public WELL

A1GW


Comments: KEEP SYSTEM MINIMUM 100' FROM WELL

Comments:

INITIAL SITE SKETCH SCALE: 1"=60'

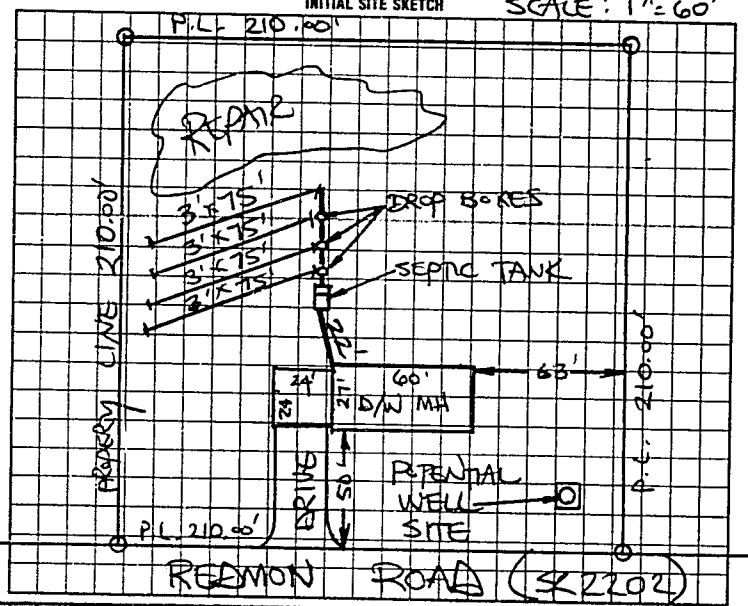

AS BUILT SKETCH

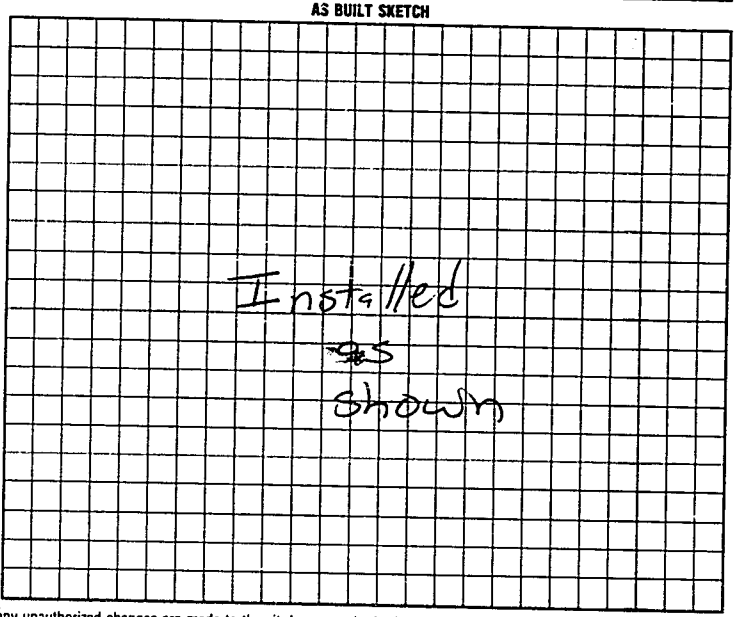

I understand that this permit can be suspended or revoked if any false information is supplied toward securing the permit/any unauthorized changes are made to the site/any unauthorized changes are made in the installation of the system. Improvement Permit is valid for 60 months from date of issuance. AUTHORIZATION TO CONSTRUCT IS VALID FOR 60 MONTHS FROM DATE OF ISSUANCE.

Signed: X Karen Gaither

Improvement Permit by: STEVE HEDRICK date 6-24-97

AUTH. TO CONST.

Existing System Inspection by: STEVE HEDRICK date 6-24-97

Installed by: Larry Reep

~~Certificate of Completion by:~~ date

Operation Permit by: Mark C Ott RS date 8-26-97

HEALTH DEPT COPY WHITE INSPECTION COPY (FINAL) GREEN OWNER COPY (FINAL) YELLOW INSPECTION COPY (INITIAL) PINK OWNER COPY (INITIAL) GOLD