2 1:00

IREDELL COUNTY HEALTH DEPARTMENT

STATESVILLE 704-878-5305 MOORESVILLE 704-664-5281

IMPROVEMENT PERMIT / AUTHORIZATION TO CONSTRUCT / OPERATION PERMIT / EXISTING SYSTEM INSPECTION

PERMIT# 52110 PIN# 4880158~~00.00~~ 7296

OWNER OR APPLICANT William Johnson PHONE: Business 704-876-6459 Home

ADDRESS 4229 Wilkinson Blvd Statesville NC 28625 DATE 7-2-08

LOCATION Hwy 21 - Harmony (R) 90 on right at 418 E. Memorial Hwy

SUBDIVISION BLOCK / SECTION LOT LOT AREA ~~2.00~~ 3.91 SITE CLASS. B DESIGN FLOW 360 L.T.A.R. .25

Septic Tank: 1000 Gallons: STB 794 Date 8-11-08

Pump Tank: Gallons: PT Date

Pump Make: Model Serial No.

Nitrification Field: No Fields Square Feet 1440 Linear Feet 360

No Lines 5 Trench Width 36" Max Trench Bottom Depth 30

☑ New System ☐ Repair ☐ Expansion System Type: I II III IV V VI

System Description: 25% Reduct

Repair System Description: 25% Reduct w/ pump

Maintenance Agreement Required: ☐ Yes ☐ No

Gravel Depth ☐ Gravity ☐ Pressure ☐ Slab ☑ Crawl Space ☐ Basement w/plumbing ☐ Basement wo/plumbing

☑ House/Mod. Home No. Bedrooms

☐ Mobile Home No. Persons

☐ Business No. Employees

☐ Other

Water Supply: ☐ Individual ☐ Public ☐ Community

Comments:/Conditions:


24" - 30" Trench Bottom

Comments:/Conditions:

Install as Contour
Maintain all setbacks


A

INITIAL SITE SKETCH

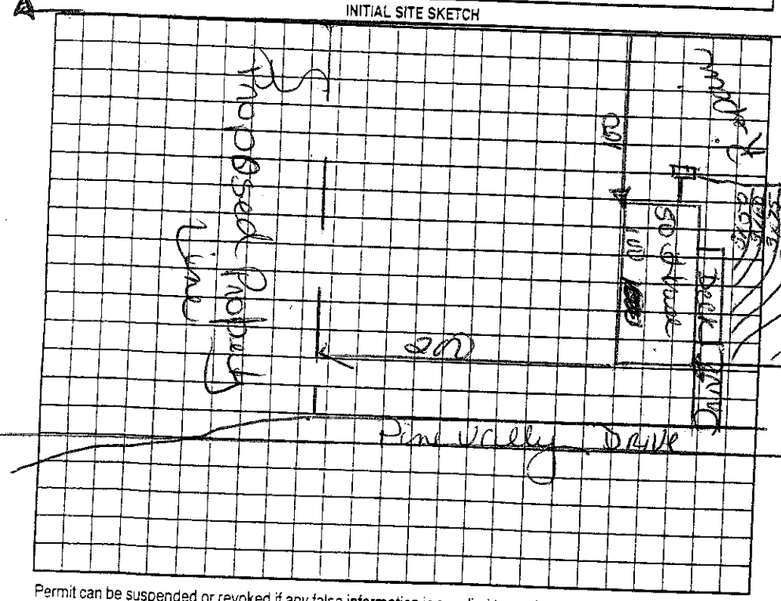

AS BUILT SKETCH

Rec'd 9/11/08

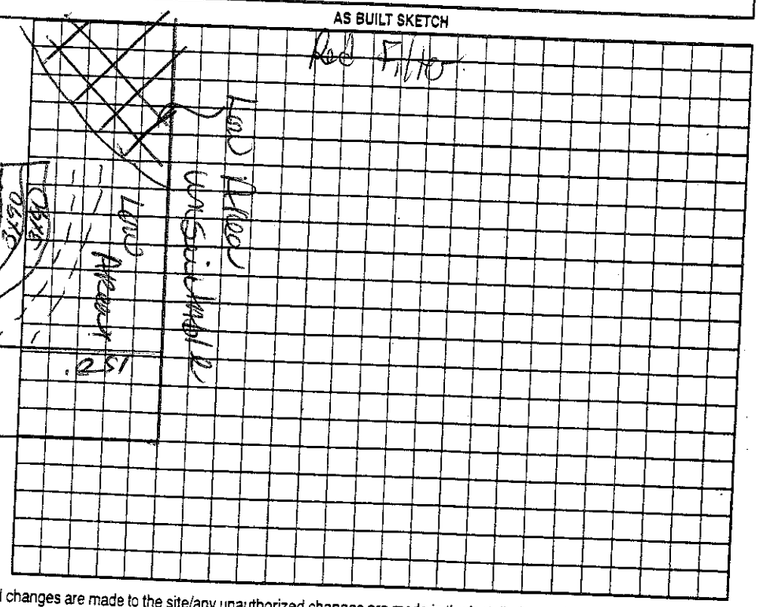

Permit can be suspended or revoked if any false information is supplied toward securing the permit/any unauthorized changes are made to the site/any unauthorized changes are made in the installation of the system. Improvement Permit with plat valid without expiration ☐ Improvement Permit with site plan valid for sixty months ☑ Authorization to Construct is valid for a period equal to that of Improvement Permit – not to exceed sixty months.

Signed: X [signature] date 9-2-08

Improvement Permit by: [signature] date 9-2-08

Authorization to Construct by: [signature] date 9-2-08

Installed by: [signature]

Operation Permit by: [signature] date 10/16/08

Existing System Inspection by: date

HEALTH DEPT. COPY: WHITE OWNER COPY (FINAL): YELLOW OWNER COPY (INITIAL): PINK