IREDELL COUNTY HEALTH DEPARTMENT

STATESVILLE 704-878-5305 MOORESVILLE 704-664-5281

IMPROVEMENT PERMIT / CERTIFICATE OF COMPLETION / OPERATION PERMIT / EXISTING SYSTEM INSPECTION

PROPERTY DESCRIPTION NO. 25229 DATE 10-14-96 TAX MAP NO. 12M-A-73 Watershed: ☐ Yes ☒ No

OWNER OR CONTRACTOR JAMES D. THARPE PHONE: Business Home 546-7983

ADDRESS 470 BUTLER MILL ROAD, HARMONY, NC, 28634

LOCATION US21 N, TR TOMLINSON AVE, CONTINUE, BUTLER MILL, ON RIGHT BEFORE POULTRY HOUSE.

SUBDIVISION BLOCK / SECTION LOT LOT AREA ACREAGE SITE CLASS PS DESIGN FLOW 240 L.T.A.R. EXISTING 0.53

Septic Tank: 1000 Gallons; STB Date

Pump Tank: Gallons; PT Date

Pump Make: Model Serial No.

Nitrification Field: No Fields 1 Square Feet 720 Linear Feet 240

No Lines 2 Trench Width Max Trench Bottom Depth Gravel Depth 12"

☐ New System ☐ Repair System Type: I, II, IV, V, VI

System Description: CONV. GRAVITY

Repair System Description:

Maintenance Agreement Required: ☐ Yes ☒ No

☐ Slab ☒ Crawl Space ☐ Basement w/plumbing ☐ Basement wo/plumbing

☐ House/Mod. Home No. Bedrooms 2

☒ Mobile Home No. Bathrooms 2

☐ Business No. Employees

☐ Other


Water Supply: ☒ Individual ☐ Community ☐ Public WELL

Comments:

Comments: ① APPROVED FOR 2 BEDROOM ONLY
② KEEP MH MINIMUM 5' FROM SYSTEM

INITIAL SITE SKETCH

AS BUILT SKETCH

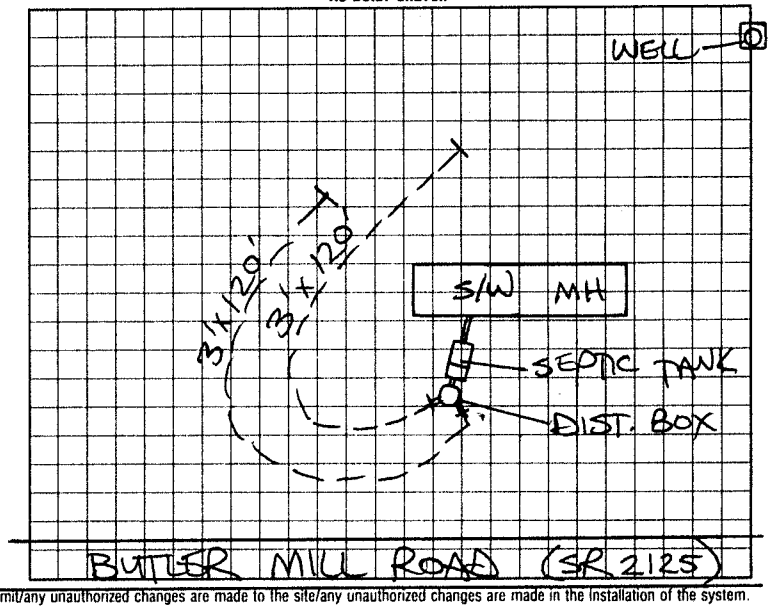

I understand that this permit can be suspended or revoked if any false information is supplied toward securing the permit/any unauthorized changes are made to the site/any unauthorized changes are made in the installation of the system.

Signed:

Improvement Permit by: date

Existing System Inspection by: STEVE THERRICK date 10-14-96

Installed by:

Certificate of Completion by: date

Operation Permit by: date

HEALTH DEPT. COPY: WHITE INSPECTION COPY (FINAL): GREEN OWNER COPY (FINAL): YELLOW INSPECTION COPY (INITIAL): PINK OWNER COPY (INITIAL): GOLD