IREDELL COUNTY HEALTH DEPARTMENT

STATESVILLE 704-878-5305 MOORESVILLE 704-664-5281

IMPROVEMENT PERMIT / AUTHORIZATION TO CONSTRUCT / OPERATION PERMIT / EXISTING SYSTEM INSPECTION

PERMIT# 076632 PIN# 4880 32 7626 DATE 10-6-98

OWNER OR CONTRACTOR MARY U. HOLTON PHONE: Business Home (336) 765-3786

ADDRESS 2626 LOCKWOOD ROAD, WINSTON - SALEM, NC 27103

LOCATION US 21 NORTH, TR NC 901, 1.9 MILE ON RIGHT (4TH DRIVE ON RIGHT PAST SHEFFIELD ROAD)

SUBDIVISION BLOCK / SECTION LOT LOT AREA 2.8418 ACRES SITE CLASS PS DESIGN FLOW 360 L.T.A.R. 0.30 GPD/FT

Septic Tank: 1000 Gallons; STB 760 Date 12.4.98
Pump Tank: Gallons; PT Date
Pump Make: Model Serial No.
Nitrification Field: No Fields 1 Square Feet 1200 Linear Feet 400
No Lines FOUR Trench Width 36" Max Trench Bottom Depth 30" Gravel Depth 12"

[✓] New System [ ] Repair System Type: I (II) III, IV, V, VI
System Description: CONVENTIONAL GRAVITY
Repair System Description: CONV. GRAVITY
Maintenance Agreement Required: [ ] Yes [✓] No
[ ] Slab [✓] Crawl Space [ ] Basement w/plumbing [ ] Basement wo/plumbing


[✓] House/Mod. Home No. Bedrooms 3
[ ] Mobile Home No. Bathrooms 2
[ ] Business No. Employees
[ ] Other

Water Supply: [ ] Individual [✓] Public [ ] Community

Comments/Conditions: CONSTRUCT SUBSURFACE INTERCEPT DRAINAGE DITCH AT LOCATION SHOWN BEGINNING 42 INCHES DEEP OUT TO DAYLIGHT

Comments/Conditions: SYSTEM INSTALLED ACCORDING TO INITAL SITE SKETCH

INITIAL SITE SKETCH SCALE: 1" = 60'

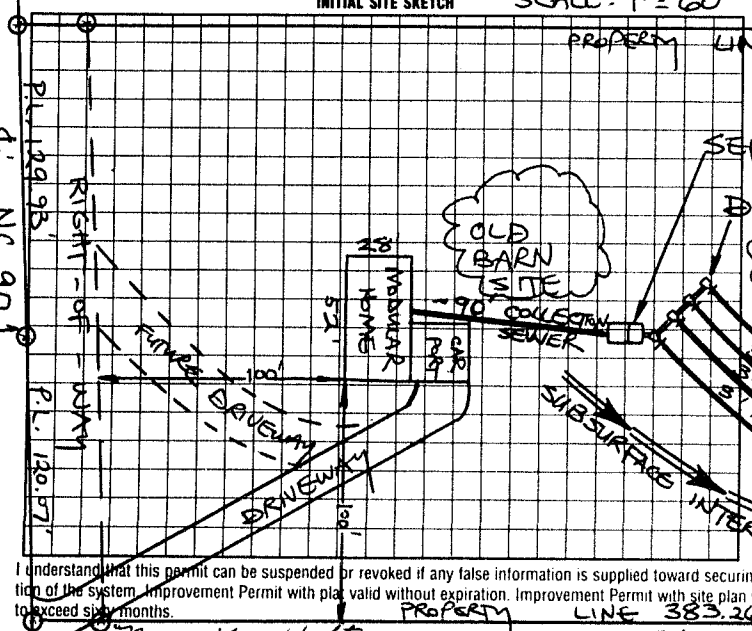

AS BUILT SKETCH

I understand that this permit can be suspended or revoked if any false information is supplied toward securing the permit/any unauthorized changes are made to the site/any unauthorized changes are made in the installation of the system. Improvement Permit with plat valid without expiration. Improvement Permit with site plan valid for sixty months. Authorization to Construct is valid for a period equal to that of Improvement Permit – not to exceed sixty months.

Signed: Mary U. Holton date 10/6/98 Installed by: BILLY GRIMES

Improvement Permit by: STEVE HEDRICK date 10-6-98 Operation Permit by: STEVE HEDRICK date 2-9-99

Authorization to Construct by: STEVE HEDACK date 10-6-98 Existing System Inspection by: date

HEALTH DEPT. COPY: WHITE INSPECTION COPY (FINAL): GREEN OWNER COPY (FINAL): YELLOW INSPECTION COPY (INITIAL): PINK OWNER COPY (INITIAL): GOLD