IREDELL COUNTY HEALTH DEPARTMENT

STATESVILLE 704-878-5305 MOORESVILLE 704-664-5281

IMPROVEMENT PERMIT / AUTHORIZATION TO CONSTRUCT / OPERATION PERMIT / EXISTING SYSTEM INSPECTION

PERMIT# Repair PIN# 4880331872 DATE 12-18-06

OWNER OR CONTRACTOR Bill Truitt PHONE: Business 704-872 6375 Home

ADDRESS 513 memorial Highway Harmony NC

LOCATION 21A TO 901 box 548

SUBDIVISION BLOCK / SECTION LOT LOT AREA .697 SITE CLASS. B DESIGN FLOW 240 L.T.A.R. 3

Septic Tank Exist Gallons; STB Date

Pump Tank: Gallons; PT Date

Pump Make: Model Serial No.

Nitrification Field: No Fields 1 Square Feet 800 Linear Feet 200

No Lines 3 Trench Width 36" Max Trench Bottom Depth 36" Gravel Depth

☐ New System ☐ Repair System Type: I, II, III, IV, V, VI

System Description: 2570 Gravity

Repair System Description:

Maintenance Agreement Required: ☐ Yes ☐ No

☑ House/Mod. Home No. Bedrooms 2

☐ Mobile Home No. Bathrooms

☐ Business No. Employees

☐ Other

☐ Slab ☑ Crawl Space ☐ Basement w/plumbing ☐ Basement wo/plumbing

Water Supply: ☐ Individual ☑ Public ☐ Community


Comments:/Conditions:

Install on Contour
Maintain all setbacks

Comments:/Conditions:

use Existing tank
unless tank is damaged

INITIAL SITE SKETCH

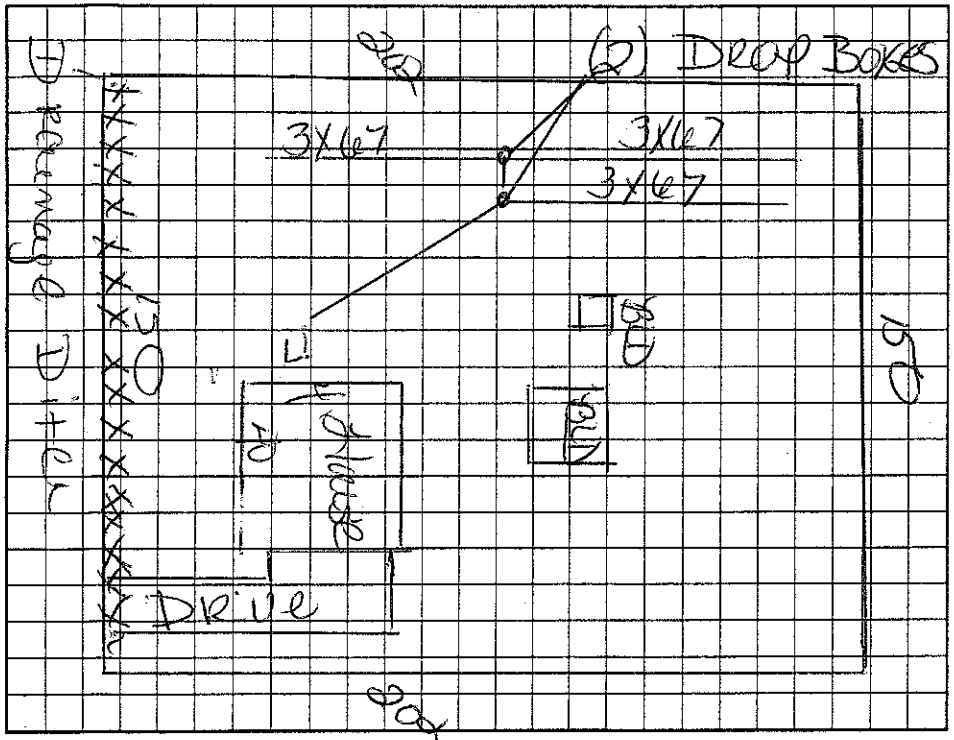

AS BUILT SKETCH

Permit can be suspended or revoked if any false information is supplied toward securing the permit/any unauthorized changes are made to the site/any unauthorized changes are made in the installation of the system. Improvement Permit with plat valid without expiration. Improvement Permit with site plan valid for sixty months. Authorization to Construct is valid for a period equal to that of Improvement Permit – not to exceed sixty months.

Signed: Billy R Truitt date 12-18-06 Installed by: Brent Eatherly

Improvement Permit by: Kelly Cook date 12-18-06 Operation Permit by: Kelly Cook date 1-31-07

Authorization to Construct by: Kelly Cook date 12-18-06 Existing System Inspection by: date

HEALTH DEPT. COPY: WHITE OWNER COPY (FINAL): YELLOW OWNER COPY (INITIAL): PINK