IREDELL COUNTY HEALTH DEPARTMENT

STATESVILLE 704-878-5305 MOORESVILLE 704-664-5281 @

IMPROVEMENT PERMIT / AUTHORIZATION TO CONSTRUCT / OPERATION PERMIT / EXISTING SYSTEM INSPECTION

PERMIT # 162695 PIN # 4880-33-~~4268~~ 1872 DATE 16 August 10

OWNER or APPLICANT Billy Twinette PHONE: ~~Business~~ (704) 546-2080 Home:

OWNER or APPLICANT ADDRESS P.O. Box 157 Harmony, NC.

LOCATION / DIRECTIONS 548 Memorial Hwy Harmony, NC

SUBDIVISION BLOCK / SECTION LOT # LOT AREA 0.342 ac. DESIGN FLOW 240 gpd L.T.A.R.

Septic Tank 1000 Gallons: STB Date

Pump Tank Gallons: P T Date

Pump Make Model Serial #

Nitrification Field No Fields 1 No Lines 1 Linear Feet 225'

Trench Width Max. Trench Bottom Depth Gravel Depth

☐ New System ☐ Repair ☐ Expansion System Type I II III IV V VI

System Description: Exist- Conventional

Repair System Description:

Maintenance Agreement Required ☐ YES ☑ NO

☑ GRAVITY ☐ PRESSURE

☑ Residence No. Bedrooms 2

☐ Business No. Persons

☐ Other No. Employees

☐ Slab ☑ Crawl Space

☐ Basement w/plumbing ☐ Basement w/o plumbing


Water Supply: ☐ Private ☑ Public ☐ Community

Comments / Conditions

Comments / Conditions Original Permit Attached. Clyde Campbell 6-14-73

INITIAL SITE SKETCH

AS BUILT SKETCH Memorial Hwy

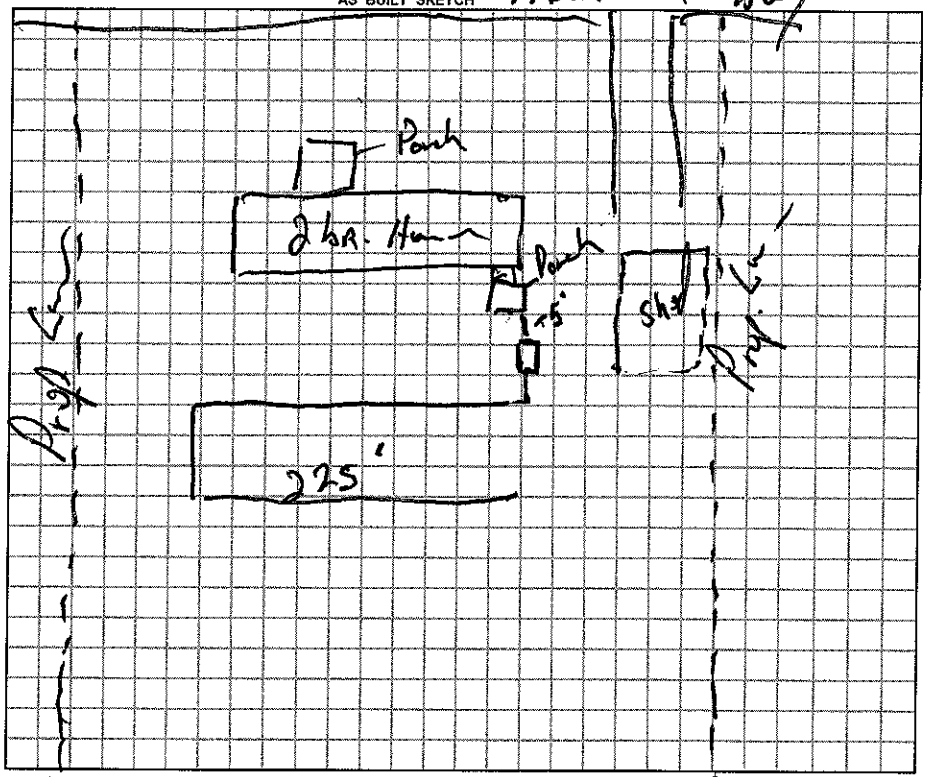

Permit can be suspended or revoked if any false information is supplied toward securing the permit / any unauthorized changes are made to the site / any unauthorized changes are made in the installation of the system.

☐ *IMPROVEMENT PERMIT w/o plat valid without expiration.* ☐ *IMPROVEMENT PERMIT w / site plan valid for 60 mos.*

☐ *AUTHORIZATION TO CONSTRUCT valid for period equal to IMPROVEMENT PERMIT-not to exceed 60 mo.*

Owner / Applicant Signature: Date 8/17/10

Improvement Permit by: Date

Authorization to Construct by: Date

YOU SHOULD CONTACT A LOCATOR SERVICE PRIOR TO ANY EXCAVATION.

Installed by:

Operation Permit by: Date:

Existing System Inspected by: R.S. Date: 16 Aug 10

WHITE COPY Environmental Health YELLOW COPY (Final) Owner / Applicant PINK COPY (Initial) Owner / Applicant