IREDELL COUNTY HEALTH DEPARTMENT

STATESVILLE 704-878-5305 MOORESVILLE 704-664-5281

IMPROVEMENT PERMIT / CERTIFICATE OF COMPLETION / OPERATION PERMIT / EXISTING SYSTEM INSPECTION

PROPERTY DESCRIPTION NO. REPAIR DATE 9-8-95 TAX MAP NO. Watershed: ☐ Yes ☒ No

OWNER OR CONTRACTOR WILLARD & FANNIE GAITHER PHONE: Business Home 546-2541

ADDRESS 528 MEMORIAL HIGHWAY, HARMONY, NC 28634

LOCATION US 21 N, TR NC 901, ON LEFT AT SHEFFIELD ROAD

SUBDIVISION BLOCK / SECTION LOT , LOT AREA SITE CLASS. PS DESIGN FLOW 360 L.T.A.R. 0.4 (EXISTING)

Septic Tank: ~~Concrete~~ Gallons; STB 978 Date 5-21-95

Pump Tank: Gallons; PT Date

Pump Make: Model Serial No.

Nitrification Field: ☐ No Fields ☐ Square Feet 450 Linear Feet 150

No Lines Trench Width 36" Max Trench Bottom Depth 18-36" Gravel Depth 12"

☐ New System ☒ Repair System Type: I II III IV V VI

System Description: CONV. GRAVITY

Repair System Description: CONV. GRAVITY

Maintenance Agreement Required: ☐ Yes ☒ No

☐ Slab ☒ Crawl Space ☐ Basement w/plumbing ☐ Basement wo/plumbing

☒ House/Mod. Home No. Bedrooms 3

☐ Mobile Home No. Bathrooms 1

☐ Business No. Employees


☐ Other

Water Supply: ☒ Individual ☐ Community ☒ Public

Comments: ① PUMP OUT & CHECK SEPTIC TANK FOR INTEGRITY REPLACE SANITARY TEE
② INSTALL NEW DIST. BOX AS SHOWN
③ INSTALL NEW 3' x 150' LINE SHOWN

Comments: LINE CHECKED 9-14-95, OK - STEVE HEDRICK

INITIAL SITE SKETCH

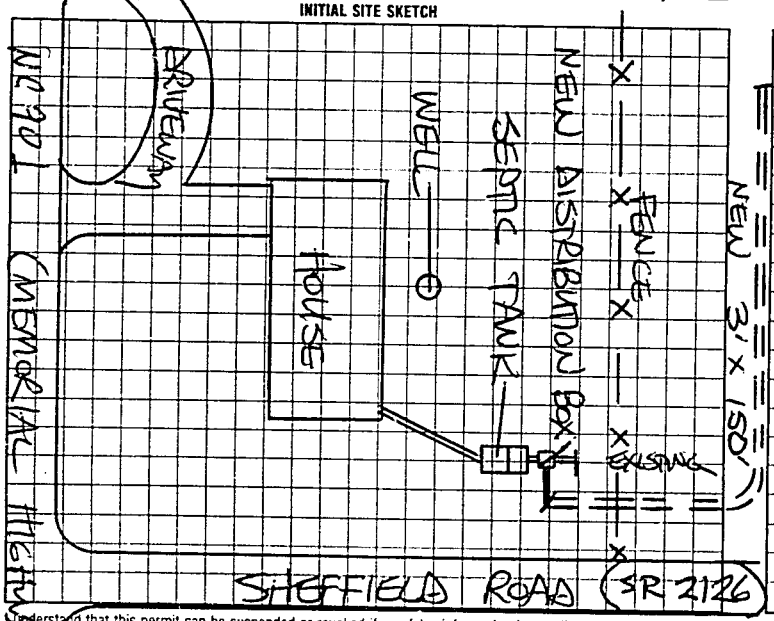

AS BUILT SKETCH

Old S.T. was replaced by new Septic Tank 9-15-95

I understand that this permit can be suspended or revoked if any false information is supplied toward securing the permit/any unauthorized changes are made to the site/any unauthorized changes are made in the installation of the system.

Signed: X Fannie S Gaither

Improvement Permit by: STEVE HEDRICK date 9-8-95

Existing System Inspection by: date

Installed by: Sammy Reavis

Certificate of Completion by: E.C. Moore date 9-15-95

Operation Permit by date

HEALTH DEPT COPY: WHITE INSPECTION COPY (FINAL): GREEN OWNER COPY (FINAL): YELLOW INSPECTION COPY (INITIAL): PINK OWNER COPY (INITIAL): GOLD

5 1 2 0 0