IREDELL COUNTY HEALTH DEPARTMENT

STATESVILLE 704-878-5305 MOORESVILLE 704-664-5281

IMPROVEMENT PERMIT / AUTHORIZATION TO CONSTRUCT / OPERATION PERMIT / EXISTING SYSTEM INSPECTION

PERMIT# 089839 PIN# 4880 33 7824 (PT) DATE 6-15-2000

OWNER OR CONTRACTOR HOWARD GAITHER PHONE: Business Home 546-3056

ADDRESS 276 SOCIETY ROAD, STATESVILLE, 28625

LOCATION US 21 N, TR No 901, TL SHEFFIELD RD, 1ST LOT ON LEFT

SUBDIVISION BLOCK / SECTION LOT LOT AREA 3.00 ACRES SITE CLASS PS DESIGN FLOW 480 L.T.A.R. EXISTING 0.33 PDKT

Septic Tank: 1000 Gallons; STB Date
Pump Tank: Gallons; PT Date
Pump Make: Model Serial No.
Nitrification Field: No Fields ↓ Square Feet 720 Linear Feet 240
No Lines TWO Trench Width 36" Max Trench Bottom Depth 36" Gravel Depth 12"

☑ New System ☐ Repair System Type: I II III IV V VI
System Description: CONVENTIONAL GRAVITY
Repair System Description: CONV. GRAVITY
Maintenance Agreement Required: ☐ Yes ☑ No
☐ Slab ☑ Crawl Space ☐ Basement w/plumbing ☐ Basement wo/plumbing


☑ House/Mod. Home No. Bedrooms 4
☐ Mobile Home No. Bathrooms 3
☐ Business No. Employees
☐ Other

Water Supply: ☐ Individual ☑ Public ☐ Community


Comments:/Conditions: ① EXISTING S/W MH TO BE REMOVED UPON OCCUPANCY OF MODULAR HOME ② EXPAND EXISTING SYSTEM AS SHOWN ③ REPLACE EXISTING DIST. BOX IF NECESSARY

Comments:/Conditions:

INITIAL SITE SKETCH

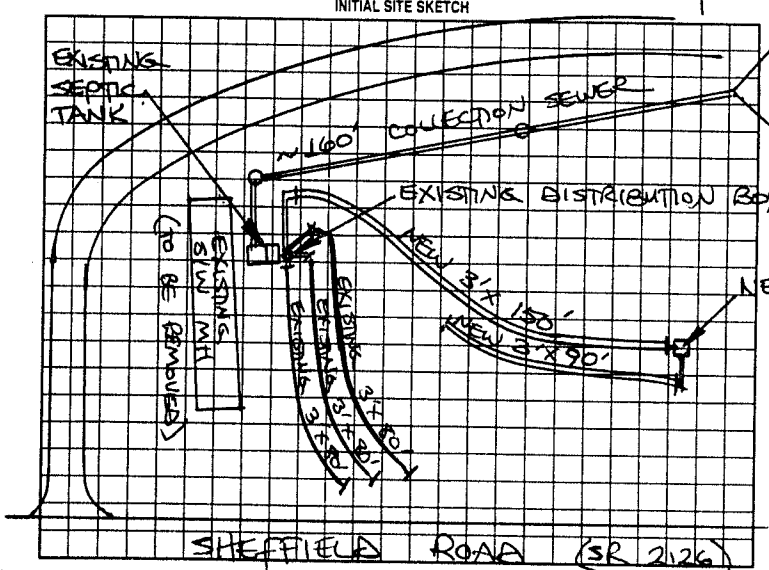

AS BUILT SKETCH

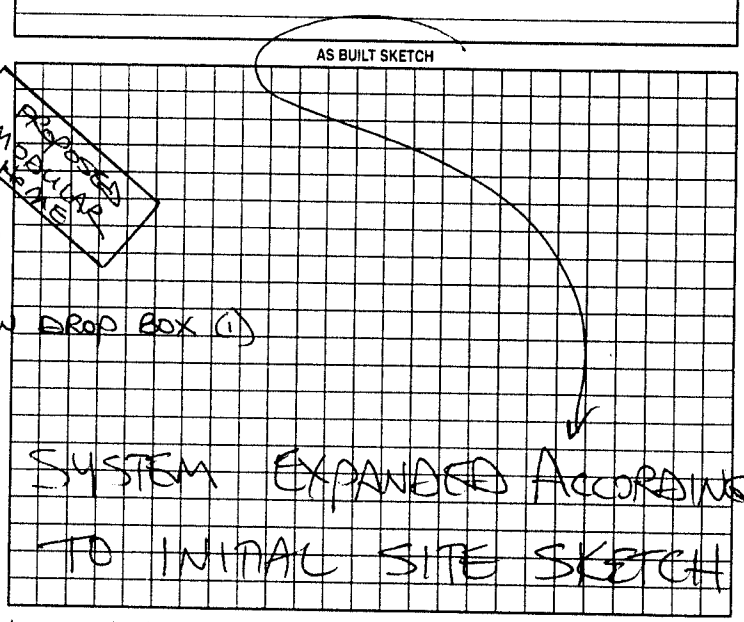

Permit can be suspended or revoked if any false information is supplied toward securing the permit/any unauthorized changes are made to the site/any unauthorized changes are made in the installation of the system. Improvement Permit with plat valid without expiration. Improvement Permit with site plan valid for sixty months. Authorization to Construct is valid for a period equal to that of Improvement Permit – not to exceed sixty months.

Signed: + Howard Gaither date 6-15-2000 Installed by: A-1 BACKHOE

Improvement Permit by: STEVE HENDRICK date 6-15-2000 Operation Permit by: STEVE HENDRICK date 8-14-00

Authorization to Construct by: STEVE HENDRICK date 6-15-2000 Existing System Inspection by: date

HEALTH DEPT. COPY: WHITE OWNER COPY (FINAL): YELLOW OWNER COPY (INITIAL): PINK