IREDELL COUNTY HEALTH DEPARTMENT

Statesville Office (704) 878-5305 Mooresville Office (704) 660-3625 PERMIT # 176878

IMPROVEMENT PERMIT / AUTHORIZATION TO CONSTRUCT / OPERATION PERMIT / EXISTING SYSTEM

PIN # 4880406164

APPLICANT: Alvaro Gonzalez APPLICANT ADDRESS: 241 N. Lackey Street

SITE ADDRESS: 419 Kinder Rd. PHONE: 704-872-6142 ALT. PHONE: N/A


SITE DIRECTIONS: I40 E Take exit #162 ~~[illegible]~~ TL Old Mocksville Rd. TL Hwy 901 TL Kinder Rd.

SUBDIVISION: Spring Hill SECTION: N/A LOT # 1 LOT AREA: 3.862 acres DESIGN FLOW: 480 gpd L.T.A.R.: 0.25

Septic Tank	1000 (gal)	STB	160 - 1000	Date	8-27-13	☑ New System ☐ Repair ☐ Expansion	System Type: I II III IV V VI	☑ Residence	No. Bedrooms 4	Water Supply
Pump Tank	(gal)	PT		Date		System Description:	25% Reduction	☐ Business	No. Persons	☐ Private
Pump Make		Model		Serial #		Repair System Description:	25% Reduction	☐ Other	No. Employees	☐ Public
# Nitrification Fields	1	# Lines	4	Linear Ft:	480	Maintenance Agreement Required:	☐ YES ☑ NO	☐ Slab	☑ Crawl Space	☐ Community
Trench Width	36"	Max. Trench Bottom Depth	36"	Gravel Depth	N/A	☑ GRAVITY	☐ PRESSURE	☐ Basement w/plumbing	☐ Basement w/o plumbing	

Comments / Conditions: Install a 25% Reduction System on contour with serial distribution.

INITIAL SITE SKETCH

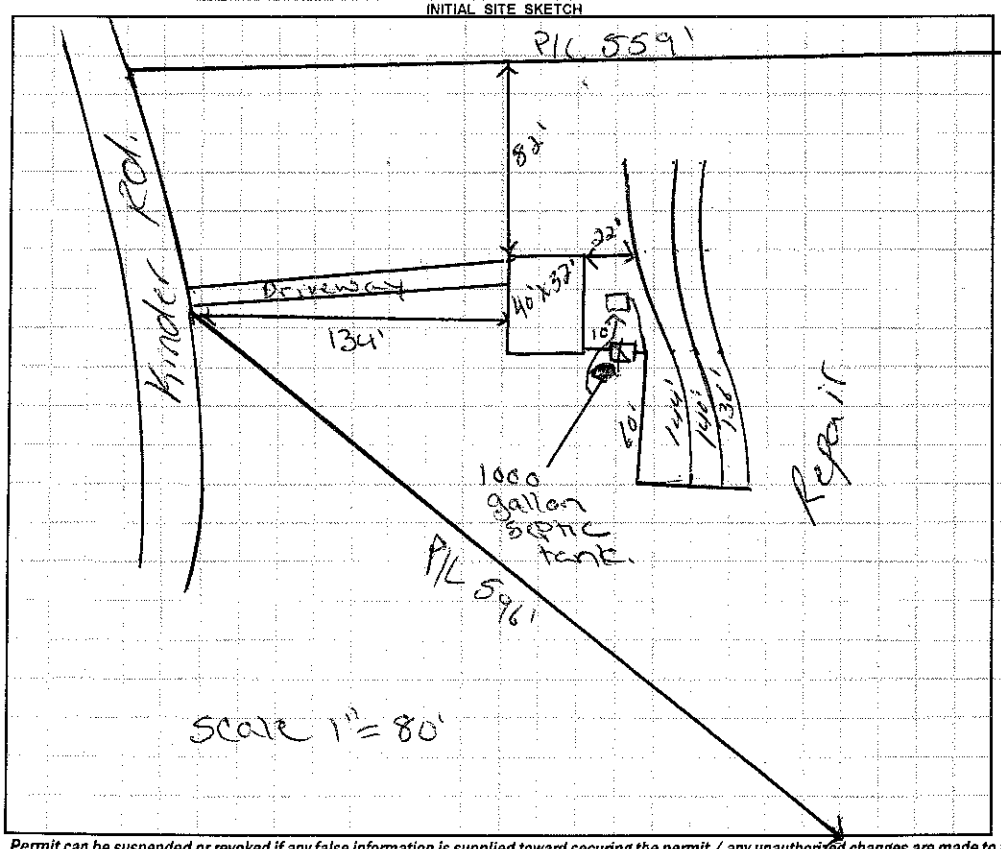

AS BUILT SKETCH

- Red Polylok Filter installed
- 2" PVC tank marker installed
- Installed as drawn

Permit can be suspended or revoked if any false information is supplied toward securing the permit / any unauthorized changes are made to the site / any unauthorized changes are made in the installation of the system. **CONTACT A LOCATOR SERVICE PRIOR TO ANY EXCAVATION**

☐ **IMPROVEMENT PERMIT** *with plat valid without expiration.* ☑ **IMPROVEMENT PERMIT** *with site plan valid for 60 mos.* ☑ **AUTHORIZATION TO CONSTRUCT** *valid for period equal to IMPROVEMENT PERMIT--not to exceed 60 mo.*

Owner / Applicant Signature: [signature] Date: 2-14-13 Installed by: Maiden Grading

IMPROVEMENT PERMIT by: Justin Henderson Date: 2-13-13 OPERATION PERMIT by: Justin Henderson Date: 11-14-13

AUTHORIZATION TO CONSTRUCT by: Justin Henderson Date: 2-13-13 Existing System Inspected by: Date:

Health Dept. Copy - WHITE Applicant (Final Approval) - YELLOW Applicant (Conditional Approval) - PINK