57634

IREDELL COUNTY HEALTH DEPARTMENT

STATESVILLE 704-878-5305 MOORESVILLE 704-664-5281

IMPROVEMENT PERMIT / CERTIFICATE OF COMPLETION / OPERATION PERMIT / EXISTING SYSTEM INSPECTION

PROPERTY DESCRIPTION NO. 21274 DATE 7-3-95 TAX MAP NO. (ART) 12J-A-3 Watershed: ☐ Yes ☒ No

OWNER OR CONTRACTOR DAVID N. SNOW PHONE: Business Home (910) 788-0361

ADDRESS API-I, 1625 ZUIDER ZEE DR WINSTON-SALEM NC 27127

LOCATION US 21N, TR NC 901 TR KINDER 1ST DRIVE ON LEFT

SUBDIVISION BLOCK / SECTION LOT LOT AREA AMPLE SITE CLASS. BS DESIGN FLOW 360 L.T.A.R. 0.3 GPD/FT2

Septic Tank: 1000 Gallons; STB 760 Date 10-27-95

Pump Tank: Gallons; PT Date

Pump Make: Model Serial No.

Nitrification Field: No Fields 1 Square Feet 1200 Linear Feet 400

No Lines 4 Trench Width 36 Max Trench Bottom Depth 36 Gravel Depth 12"

☒ New System ☐ Repair System Type: I, II, III, IV, V, VI

System Description: CONV. GRAVITY

Repair System Description: CONV. GRAVITY

Maintenance Agreement Required: ☐ Yes ☒ No

☒ House/Mod. Home No. Bedrooms 3

☐ Mobile Home No. Bathrooms 2

☐ Business No. Employees

☐ Other


☐ Slab ☒ Crawl Space ☐ Basement w/plumbing ☐ Basement wo/plumbing

Water Supply: ☐ Individual ☐ Community ☒ Public


Comments: ① KEEP SYSTEM MINIMUM 5' FROM HOUSE, 10' FROM PROPERTY LINE, 10' FROM WATER LINE. ② INSTALL LINES AS SHOWN, NO DEEPER THAN 36", 9' MINIMUM APART ON CENTER.

Comments:

INITIAL SITE SKETCH

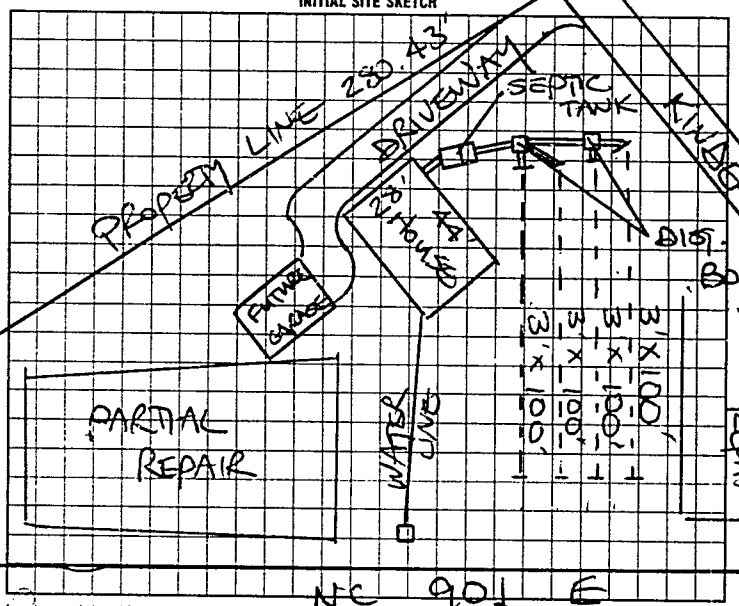

AS BUILT SKETCH

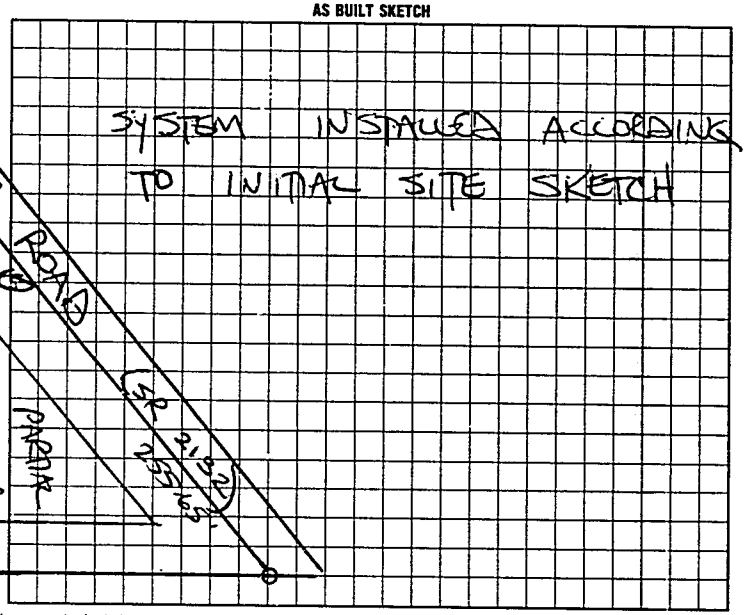

I understand that this permit can be suspended or revoked if any false information is supplied toward securing the permit/any unauthorized changes are made to the site/any unauthorized changes are made in the installation of the system. Improvement Permit is valid for 60 months from date of issuance.

Signed:

Improvement Permit by: STEVE HENDRICK date 7/3/95

Existing System Inspection by: date

Installed by: BILLY GRIMES

Certificate of Completion by: date

Operation Permit by: STEVE HENDRICK date 12-28-95

HEALTH DEPT. COPY: WHITE INSPECTION COPY (FINAL): GREEN OWNER COPY (FINAL): YELLOW INSPECTION COPY (INITIAL): PINK OWNER COPY (INITIAL): GOLD

67100