IREDELL COUNTY HEALTH DEPARTMENT

STATESVILLE 704-878-5305 MOORESVILLE 704-664-5281

IMPROVEMENT PERMIT / AUTHORIZATION TO CONSTRUCT / OPERATION PERMIT / EXISTING SYSTEM INSPECTION

PERMIT# REPAIR PIN# 4880-62-9249 DATE 3-9-04

OWNER OR CONTRACTOR MARGARET DOLLYHIGH PHONE: Business Home 336-786-5805

ADDRESS 318 WELCH RD. MT. AIRY NC 27030

LOCATION I-77N EXIT 65 (R) 901 (L) SKYVIEW LAKE RD PROP ON (L)

SUBDIVISION BLOCK / SECTION LOT LOT AREA .29 SITE CLASS. PS DESIGN FLOW 240 L.T.A.R. EXISTING

Septic Tank: 1000 Gallons; STB 1012 Date 1-18-04

Pump Tank: 1000 Gallons; PT 17 Date 10-12-03

Pump Make: Goulds Model WE03 Serial No [redacted]

Nitrification Field: No Fields 1 Square Feet EQ 800 Linear Feet 210

No Lines 3 Trench Width 36" Max Trench Bottom Depth 24"

☐ New System ☑ Repair System Type: I, II, (III), IV, V, VI

System Description:

Repair System Description: PUMP 25% REDUCTION

Maintenance Agreement Required: ☐ Yes ☑ No

Gravel Depth N/A ☐ Slab ☑ Crawl Space ☐ Basement w/plumbing ☐ Basement wo/plumbing

☐ House/Mod. Home ☑ Mobile Home ☐ Business ☐ Other


No. Bedrooms 2 No. Bathrooms 1 No. Employees

Water Supply: ☐ Individual ☑ Public ☑ Community


Comments/Conditions: (1) MAINTAIN SETBACKS (2) INSTALL LINES ON CONTOUR 24" (3) NOV SENT 3-2-04. (4) MUST RE-ROUTE PUBLIC WATERLINE TO HAVE EITHER 10' SEPARATION FROM SEPTIC OR 18" SEPARATION!

Comments/Conditions: (1) Pump to panel 50% reduction system (2) 33 panels total (3) Tuff-tite filter (4) Supply line sleeved (5) System installed on contour

SCALE 1" = 30' INITIAL SITE SKETCH OVER SUPPLY LINE.

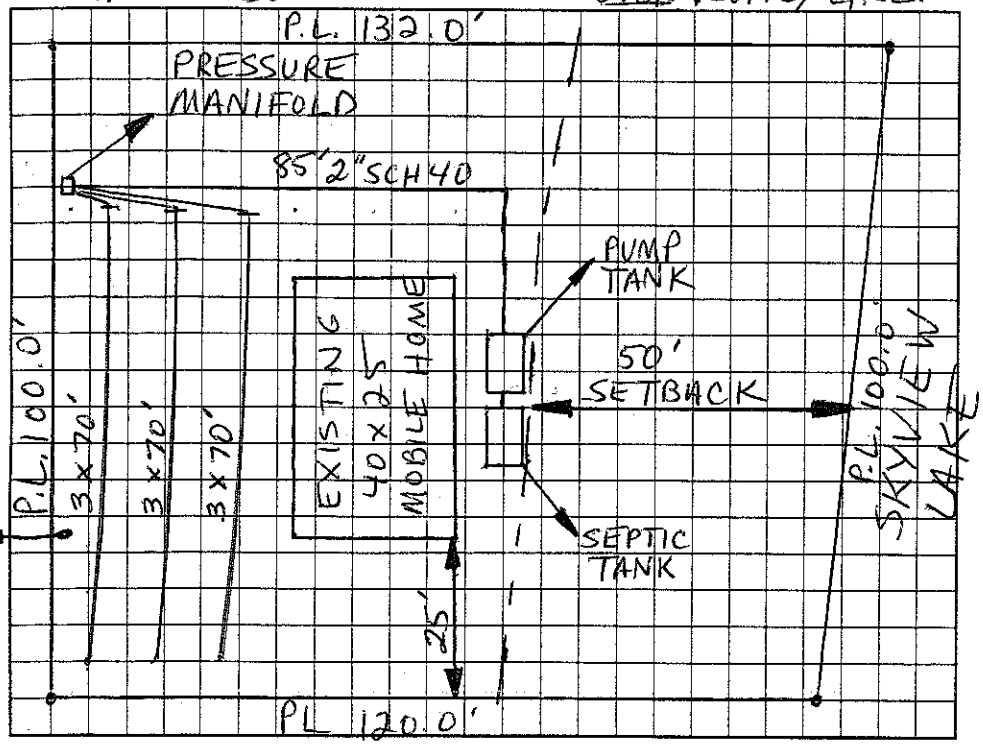

Scale 1" = 30' AS BUILT SKETCH

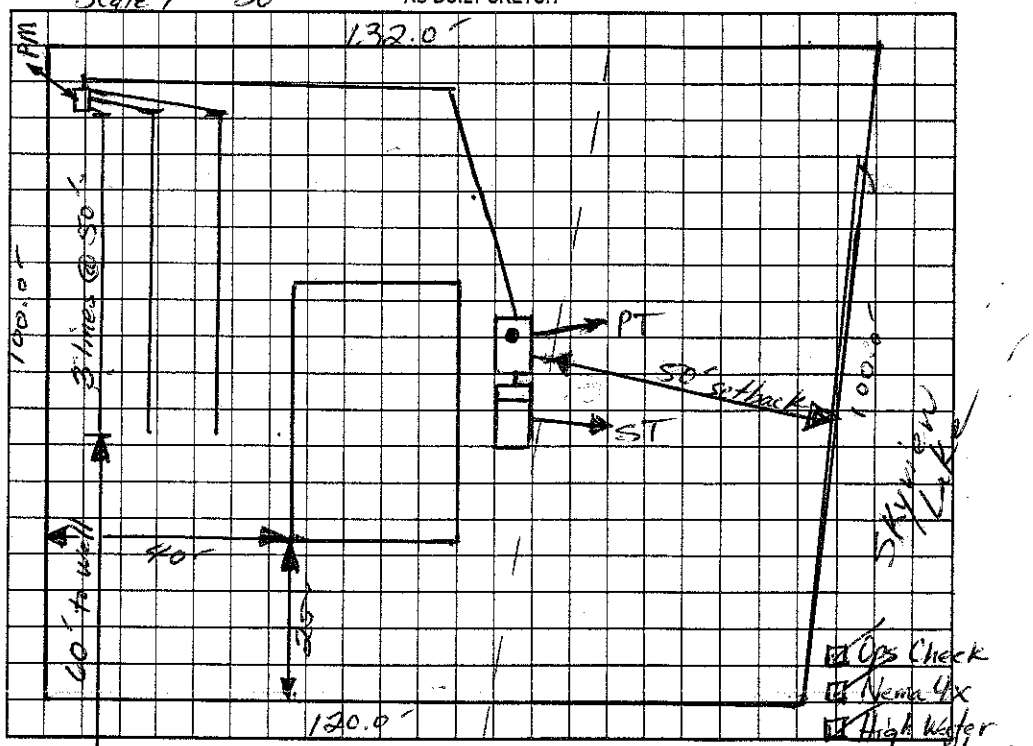

Permit can be suspended or revoked if any false information is supplied toward securing the permit/any unauthorized changes are made to the site/any unauthorized changes are made in the installation of the system. Improvement Permit with plat valid without expiration. Improvement Permit with site plan valid for sixty months. Authorization to Construct is valid for a period equal to that of Improvement Permit – not to exceed sixty months.

Signed: Angela M. Wheeler date 3-23-04 Installed by: Piedmont Backhoe

Improvement Permit by: Christopher M. Shemwell RS date 3-9-04 Operation Permit by: Christopher M. Shemwell, RS date 7-12-04

Authorization to Construct by: Christopher M. Shemwell, RS date 3-9-04 Existing System Inspection by: date

HEALTH DEPT. COPY: WHITE OWNER COPY (FINAL): YELLOW OWNER COPY (INITIAL): PINK