# IREDELL COUNTY HEALTH DEPARTMENT

STATESVILLE 704-878-5305 — MOORESVILLE 704-664-5281

## IMPROVEMENT PERMIT / CERTIFICATE OF COMPLETION / OPERATION PERMIT / EXISTING SYSTEM INSPECTION

~~6223~~ ~~6223~~

PROPERTY DESCRIPTION NO. 25582 DATE 12-19-96 TAX MAP NO. 12J-2A (PIN# 4880720120)

OWNER OR CONTRACTOR STEPHEN HIGGINBOTHAM PHONE: Business Watershed: ☐ Yes ☑ No

ADDRESS 214 SKYVIEW LAKE ROAD, HARMONY, NC 28634 Home 546-7364

LOCATION US 21 N, TR NC901, TL SKYVIEW LAKE ROAD, REAR RIGHT 6TH LOT ON (R) PAST UPPER POND.

SUBDIVISION SKYVIEW LAKE BLOCK / SECTION LOT 6 LOT AREA 100 X 258' SITE CLASS. PS DESIGN FLOW 480 L.T.A.R. EXISTING

Septic Tank: EXISTING Gallons; STB Date

Pump Tank: Gallons; PT Date

Pump Make: Model Serial No.

Nitrification Field: No Fields 1 Square Feet 240 Linear Feet 80

No Lines 1 Trench Width 36" Max Trench Bottom Depth 36" Gravel Depth 12"

☑ New System ☐ Repair System Type: I, II, III, IV, V, VI

System Description: CONVENTIONAL GRAVITY

Repair System Description: CONV. PUMP FED

Maintenance Agreement Required: ☐ Yes ☑ No

☐ House/Mod. Home ☑ Mobile Home ☐ Business ☐ Other

No. Bedrooms 4 No. Bathrooms 2 No. Employees


☐ Slab ☑ Crawl Space ☐ Basement w/plumbing ☐ Basement wo/plumbing

Water Supply: ☐ Individual ☐ Community ☑ Public


Comments: ① RELOCATE WATER LINE MINIMUM 10' FROM SYSTEM ② INSTALL ACCESS MANHOLE RISERS ON INLET AND OUTLET OPENINGS TO GROUND SURFACE ON SEPTIC TANK PER ORGINAL PERMIT (9-3-81)

Comments:

INITIAL SITE SKETCH

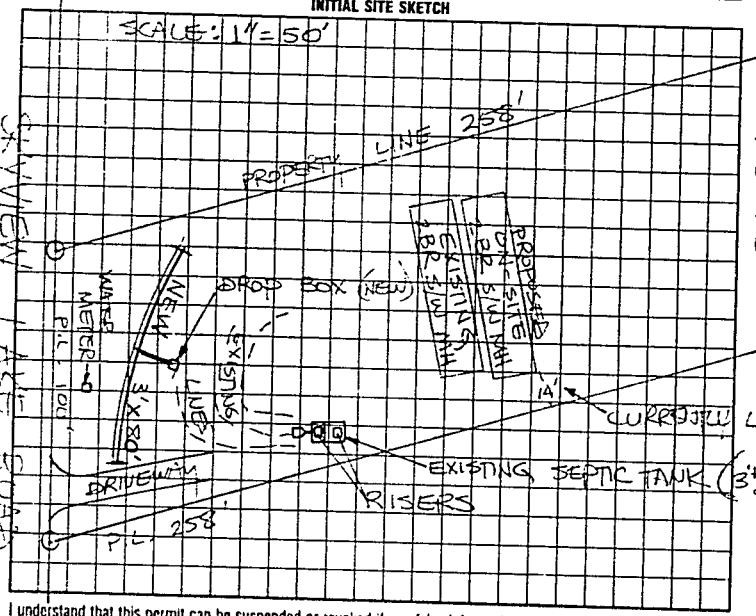


AS BUILT SKETCH

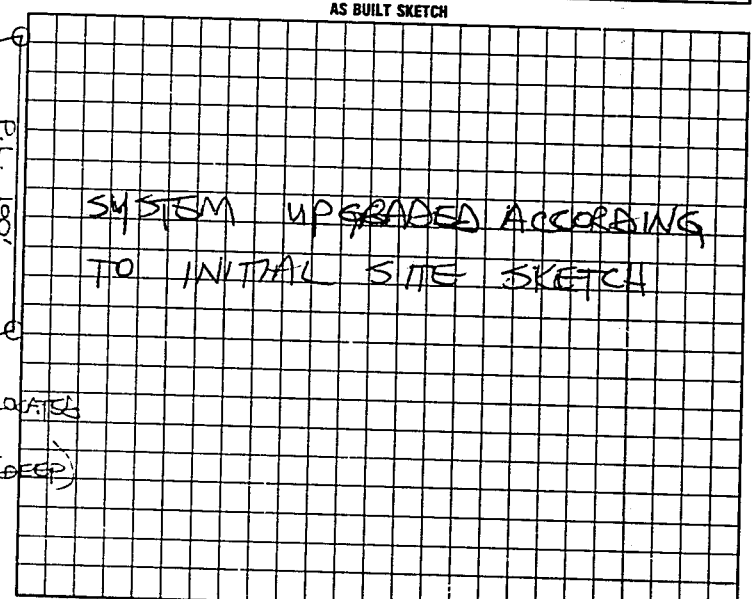


I understand that this permit can be suspended or revoked if any false information is supplied toward securing the permit/any unauthorized changes are made to the site/any unauthorized changes are made in the installation of the system. Improvement Permit is valid for 60 months from date of issuance. AUTH. TO CONST. IS VALID FOR 60 MONTHS.

Signed: [signature]

Improvement Permit by: STEVE HEDRICK date 12-19-96

Auth. To Const.

Final System Inspection by: STEVE HEDRICK date 12-19-96

Installed by: A-1 BACKHOE

Certificate of Completion by: date

Operation Permit by: STEVE HEDRICK date 1-6-97

HEALTH DEPT. COPY WHITE — INSPECTION COPY (FINAL) GREEN — OWNER COPY (FINAL) YELLOW — INSPECTION COPY (INITIAL) PINK — OWNER COPY (INITIAL) GOLD