IREDELL COUNTY HEALTH DEPARTMENT

STATESVILLE 704-878-5305 MOORESVILLE 704-664-5281

IMPROVEMENT PERMIT / CERTIFICATE OF COMPLETION / OPERATION PERMIT / EXISTING SYSTEM INSPECTION

PROPERTY DESCRIPTION NO. 24295 DATE 7-25-96 TAX MAP NO. 12J-2-A-6 Watershed: ☐ Yes ☒ No

OWNER OR CONTRACTOR STEPHEN HIGGINBOTHAM PHONE: Business Home 876-2118

ADDRESS 214 SKYVIEW LAKE ROAD HARMONY 28634

LOCATION US 21 N, TR NC901, TL SKYVIEW LAKE RD, BEAR RIGHT, 6TH LOT ON RIGHT PAST UPPER POND

SUBDIVISION SKYVIEW LAKE BLOCK / SECTION LOT 6 LOT AREA LIMITED SITE CLASS PS DESIGN FLOW 240 L.T.A.R. EXISTING

Septic Tank: EXISTING Gallons; STB Date

Pump Tank: Gallons; PT Date

Pump Make: Model Serial No.

Nitrification Field: No Fields Square Feet Linear Feet EXISTING

No Lines Trench Width Max Trench Bottom Depth Gravel Depth EXISTING

☐ New System ☐ Repair System Type: I ☒ II, IV, V, VI

System Description: CONV. GRAVITY

Repair System Description: CONV. GRAVITY

Maintenance Agreement Required: ☐ Yes ☒ No

☐ Slab ☒ Crawl Space ☐ Basement w/plumbing ☐ Basement wo/plumbing

☐ House/Mod. Home ☒ Mobile Home ☐ Business ☐ Other

No. Bedrooms 2 No. Bathrooms 2 No. Employees


Water Supply: ☐ Individual ☐ Community ☒ Public

Comments:

Comments: SYSTEM INSTALLED DEEPER THAN TODAYS STANDARDS — KEEP MH MINIMUM 5' FROM SYSTEM

INITIAL SITE SKETCH

AS BUILT SKETCH

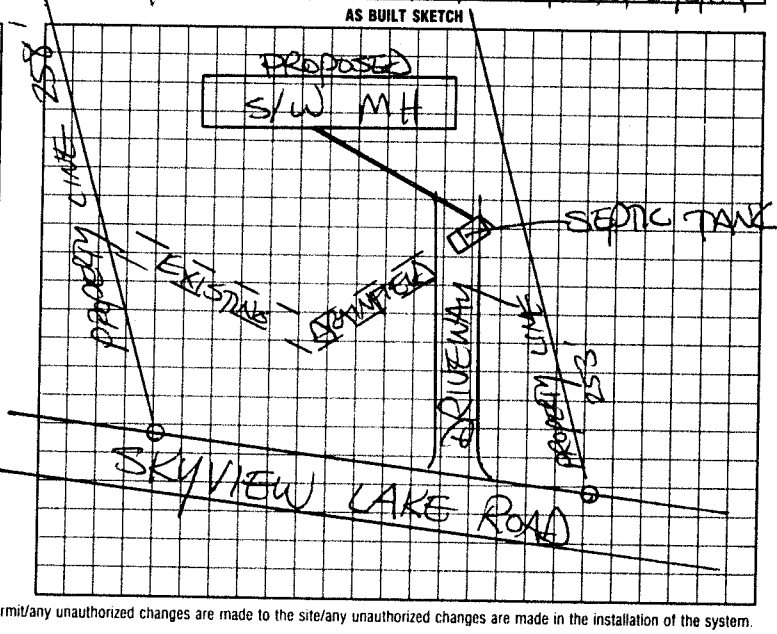

I understand that this permit can be suspended or revoked if any false information is supplied toward securing the permit/any unauthorized changes are made to the site/any unauthorized changes are made in the installation of the system.

Signed:

Improvement Permit by: date

Existing System Inspection by: STEVE HENDRICK date 7-25-96

Installed by:

Certificate of Completion by: date

Operation Permit by: date

HEALTH DEPT. COPY: WHITE INSPECTION COPY (FINAL): GREEN OWNER COPY (FINAL) YELLOW INSPECTION COPY (INITIAL) PINK OWNER COPY (INITIAL): GOLD