IREDELL COUNTY HEALTH DEPARTMENT

STATESVILLE 704-878-5305 MOORESVILLE 704-664-5281

IMPROVEMENT PERMIT / AUTHORIZATION TO CONSTRUCT / OPERATION PERMIT / EXISTING SYSTEM INSPECTION

PERMIT# REPAIR PIN# 4880-72-0340 DATE 3-18-04

OWNER OR CONTRACTOR MARK & SANDRA HATCHER PHONE: Business (704) 978-2712 Home

ADDRESS 217 SKYVIEW LAKE RD. HARMONY, NC 28634

LOCATION I-77N EXIT 65 (R) 901 (L) SKYVIEW LAKE RD. PROPERTY NEAR END ON (L)

SUBDIVISION BLOCK / SECTION LOT LOT AREA ~.28 SITE CLASS. PS DESIGN FLOW 360 L.T.A.R. EXISTING

Septic Tank: EXISTING Gallons; STB Date

Pump Tank: 1000 Gallons; PT 274 Date 4-5-04

Pump Make: Model Serial No.

Nitrification Field: No Fields 1 Square Feet Linear Feet 150

No Lines 5 Trench Width 24" Max Trench Bottom Depth 36"

☐ New System ☑ Repair System Type: I, II, III, (IV), V, VI

System Description:

Repair System Description: LP PANEL 50% RED.

Maintenance Agreement Required: ☑ Yes ☐ No

Gravel Depth 24" SAND ☐ Slab ☐ Crawl Space ☑ Basement w/plumbing ☐ Basement wo/plumbing

☑ House/Mod. Home No. Bedrooms 3

☐ Mobile Home No. Bathrooms 1


☐ Business No. Employees

☐ Other


Water Supply: ☐ Individual ☑ Public ☐ Community

Comments:/Conditions: (1) MAINTAIN SETBACKS (2) WILL REQUIRE RECORDED DEED OF EASEMENT ON LINES OVER PROP. LINE BEFORE AC CAN BE ISSUED (3) RECOMMEND NOT DRIVING OVER AREA WHERE GATE VALVE BOX + SEPTIC LINES INSTALLED. (4) WILL NEED TO REMOVE MAPLE TREES BEFORE INSTALLATION.

Comments:/Conditions:

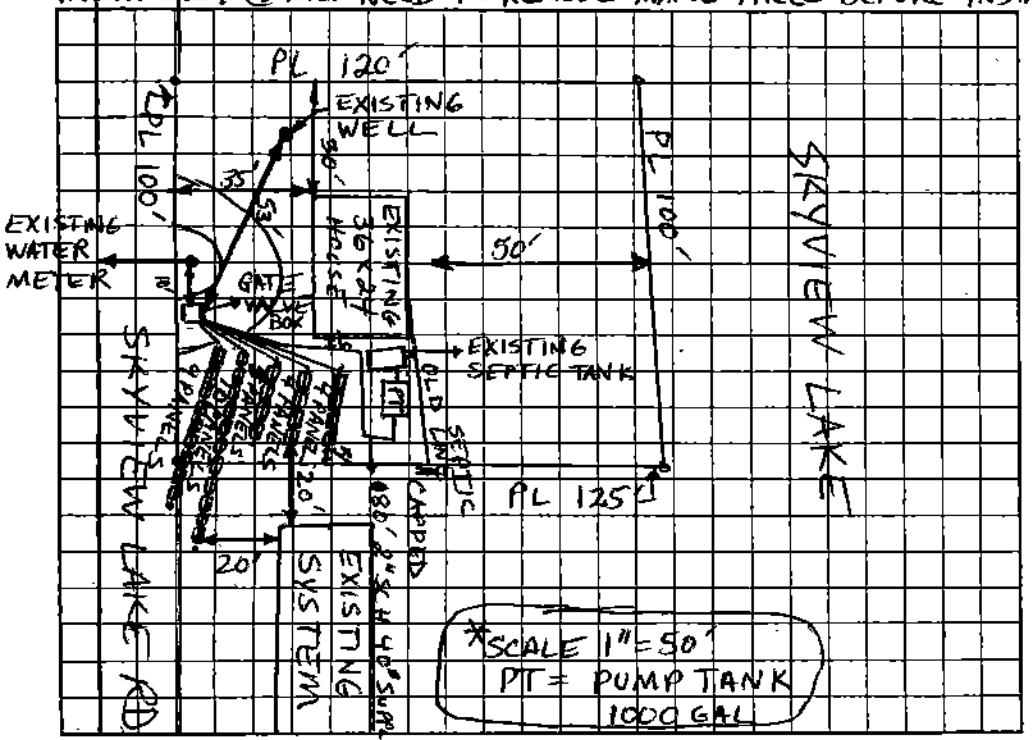

AS BUILT SKETCH

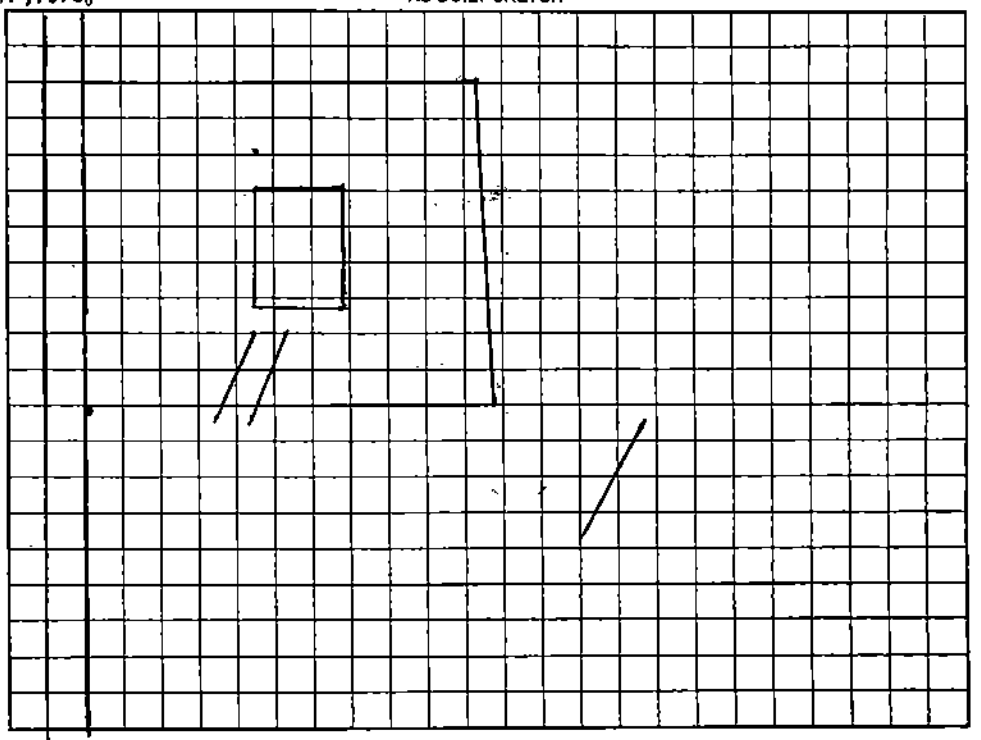

Permit can be suspended or revoked if any false information is supplied toward securing the permit/any unauthorized changes are made to the site/any unauthorized changes are made in the installation of the system. Improvement Permit with plat valid without expiration. Improvement Permit with site plan valid for sixty months. Authorization to Construct is valid for a period equal to that of Improvement Permit – not to exceed sixty months.

Signed: Sandra Hatcher date 3-19-04

Improvement Permit by: Christopher M. Sewell, RS date 3-18-04

Authorization to Construct by: Christopher M. Sewell, RS date 5-10-04

Installed by: Cadell Backhoe

Operation Permit by: Christopher M. Sewell, RS date 5-21-04

Existing System Inspection by: date

HEALTH DEPT. COPY: WHITE OWNER COPY (FINAL): YELLOW OWNER COPY (INITIAL): PINK