IREDELL COUNTY HEALTH DEPARTMENT

STATESVILLE 704-878-5305 MOORESVILLE 704-664-5281

IMPROVEMENT PERMIT / AUTHORIZATION TO CONSTRUCT / OPERATION PERMIT / EXISTING SYSTEM INSPECTION

PERMIT# REPAIR PIN# 4880-72-1331 DATE 6-03-03

OWNER OR CONTRACTOR RICHARD W. PERKINS PHONE: Business 704-878-3360 Home 704-546-3414

ADDRESS 221 SKYVIEW LAKE ROAD, HARMONY NC 28634-9036

LOCATION US 21 N, T/R NC 901, TL, SKYVIEW LAKE ROAD, BEAR RIGHT, MH ON LEFT AT #221

SUBDIVISION _____ BLOCK / SECTION _____ LOT _____ LOT AREA _____ SITE CLASS. PS DESIGN FLOW 240 L.T.A.R. EXISTING

Septic Tank: 1000 Gallons; STB 1007 Date 4-4-03
Pump Tank: _____ Gallons; PT _____ Date _____
Pump Make: _____ Model _____ Serial No. _____
Nitrification Field: No Fields 1 Square Feet 450 Linear Feet 150
No Lines THREE Trench Width 36" Max Trench Bottom Depth 36" +/- Gravel Depth 20"

☐ New System ☑ Repair System Type: I II III IV V VI
System Description: CONVENTIONAL GRAVITY
Repair System Description: CONV. GRAVITY
Maintenance Agreement Required: ☐ Yes ☑ No

☐ House/Mod. Home ☑ Mobile Home ☐ Business ☐ Other
No. Bedrooms 2 No. Bathrooms 1 No. Employees _____

☐ Slab ☑ Crawl Space ☐ Basement w/plumbing ☐ Basement wo/plumbing


Water Supply: ☐ Individual ☑ Public ☐ Community

Comments/Conditions: ① INSTALL NEW TANK & LINES AS SHOWN USING 20" STONE, ② REROUTE WATER LINE AROUND TANK AS SHOWN,

Comments/Conditions: SEPTIC TANK WITH "POLYLOK" FILTER & MARKER INSTALLED

~SCALE: 1" = 30'

INITIAL SITE SKETCH

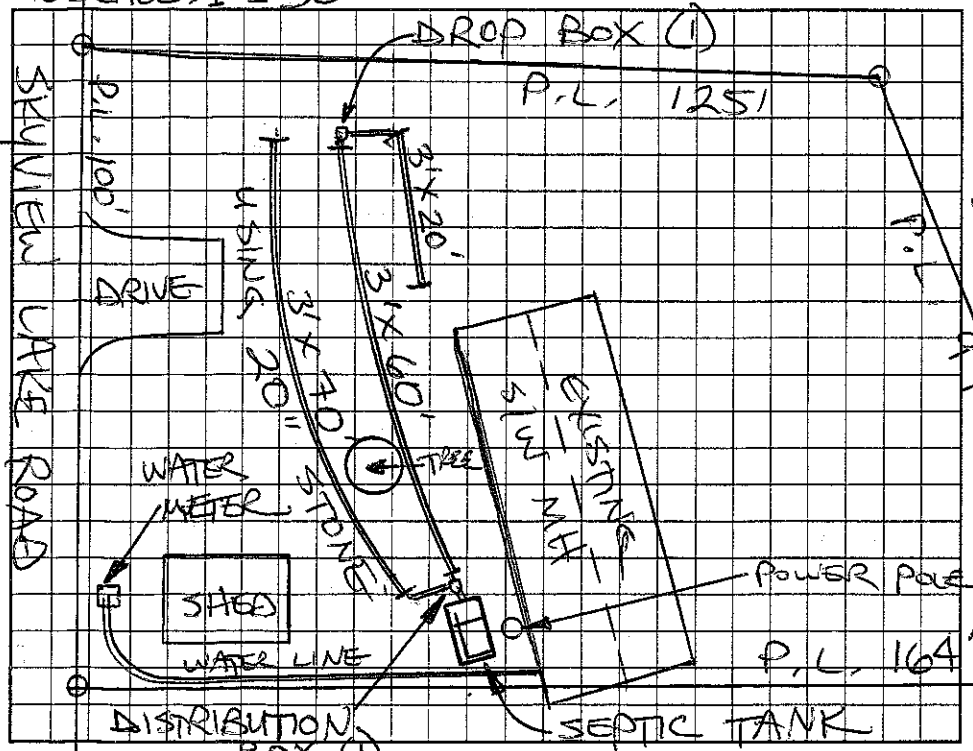

AS BUILT SKETCH

SYSTEM INSTALLED ACCORDING TO INITIAL SITE SKETCH

Permit can be suspended or revoked if any false information is supplied toward securing the permit/any unauthorized changes are made to the site/any unauthorized changes are made in the installation of the system. Improvement Permit with plat valid without expiration. Improvement Permit with site plan valid for sixty months. Authorization to Construct is valid for a period equal to that of Improvement Permit – not to exceed sixty months.

Signed Richard W Perkins date 6-3-03 Installed by: IREDELL BACKHOE

Improvement Permit by: STEVE HEDRICK date 6-03-03 Operation Permit by: STEVE HEDRICK date 6-6-03

Authorization to Construct by: STEVE HEDRICK date 6-03-03 Existing System Inspection by: _____ date _____

HEALTH DEPT. COPY: WHITE OWNER COPY (FINAL): YELLOW OWNER COPY (INITIAL): PINK