47468

IREDELL COUNTY HEALTH DEPARTMENT

STATESVILLE 704-878-5305 MOORESVILLE 704-664-5281

IMPROVEMENT PERMIT / CERTIFICATE OF COMPLETION / OPERATION PERMIT / EXISTING SYSTEM INSPECTION

PROPERTY DESCRIPTION NO. 16189 DATE 6-2-93 TAX MAP NO. 12m-A-41

OWNER OR CONTRACTOR Curtis + Retha Gaither PHONE: Business Home

ADDRESS

LOCATION US21 N TR 901 at Harmony 2mi TR Skyview Dr. follow to end

SUBDIVISION Skyview Lake Park BLOCK / SECTION LOT 142 LOT AREA Ample SITE CLASS. L.T.A.R.

Water Supply: ☐ Individual ☐ Community ☑ Public

Septic Tank: 1000 Gallons: STB 620 Date 5-5-93

Pump Tank: Gallons; PT Date

Nitrification Field: No Fields 1 Square Feet 900 Linear Feet 300

No Lines 3 Trench Width 36" Trench Depth 36" Gravel Depth 12"

☑ New System ☐ Repair System Type: I, II, III, IV, V, VI

System Description: Conv. Gravity

Repair System Description:

Maintenance Agreement Required: ☐ Yes ☑ No

☐ House/Mod. Home No. Bedrooms 3 Garbage Disposal: ☐ Yes ☑ No

☑ Mobile Home No. Bathrooms 2 Auto. Dishwasher: ☐ Yes ☐ No


☐ Business No. Employees Auto. Washing Machine: ☐ Yes ☐ No

☐ Other Other


☐ Slab ☑ Crawl Space ☐ Basement w/plumbing ☐ Basement wo/plumbing

Comments

INITIAL SITE SKETCH

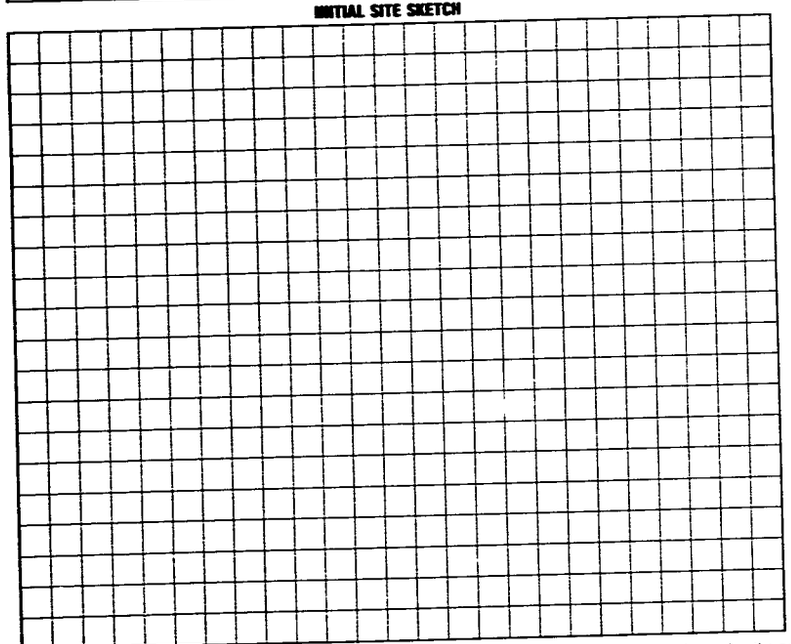

AS BUILT SKETCH

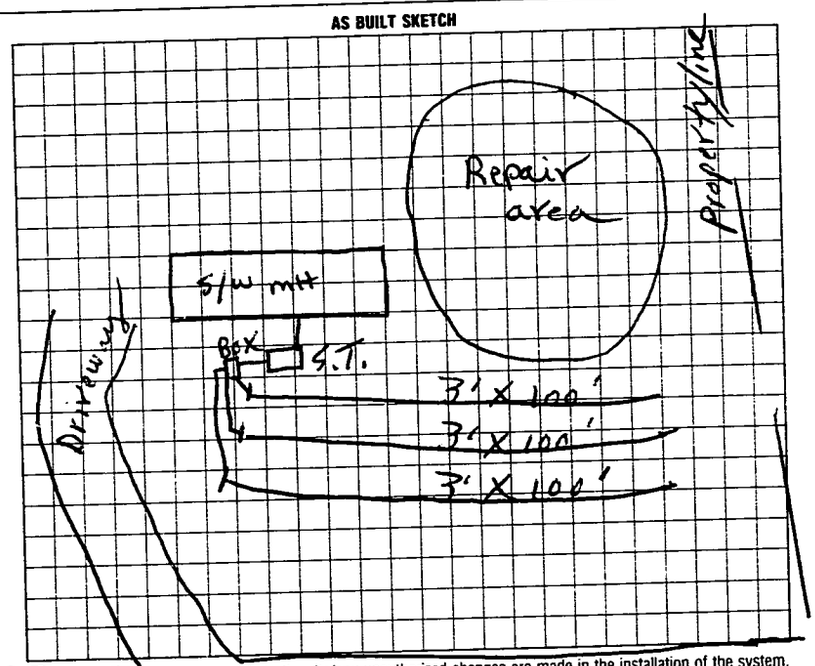

I understand that this permit can be suspended or revoked if any false information is supplied toward securing the permit/any unauthorized changes are made to the site/any unauthorized changes are made in the installation of the system. Improvement Permit is valid for 60 months from date of issuance.

Signed:

Improvement Permit by: Steve Hetrick date 4/26/93

Existing System Inspection by: date

Installed by: Sammy Reavis

Certificate of Completion by: C. C. Moore date 6-2-93

Operation Permit by: date

HEALTH DEPT. COPY: WHITE INSPECTION COPY (FINAL): GREEN OWNER COPY (FINAL): YELLOW INSPECTION COPY (INITIAL): PINK OWNER COPY (INITIAL): GOLD