IREDELL COUNTY HEALTH DEPARTMENT

STATESVILLE 704-878-5305 SI MOORESVILLE 704-664-5281

(4) IMPROVEMENT PERMIT / AUTHORIZATION TO CONSTRUCT / OPERATION PERMIT / EXISTING SYSTEM INSPECTION

PERMIT# 108351 PIN# 4880-94-1957 DATE 8-21-02

OWNER OR CONTRACTOR RALPH (GLEN) CAMPBELL PHONE Business Home 704-546-7375

ADDRESS 711 EAST MEMORIAL HIGHWAY, HARMONY, NC 28634

LOCATION US21 N, TR NC 901, TL SHEFFIELD ROAD, 2ND DRIVE ON LEFT PAST DYSON ROAD

SUBDIVISION BLOCK / SECTION LOT LOT AREA 3.62 ACRES SITE CLASS PS DESIGN FLOW 360 LTAR 0.40 GPD/FT²

Septic Tank: 1000 Gallons: STB 760 Date 4-9-02
Pump Tank: Gallons: PT Date
Pump Make: Model Serial No
Nitrification Field: No Fields I Square Feet 900 Linear Feet 300
No Lines THREE Trench Width 36" Max Trench Bottom Depth 24" Gravel Depth 12"

✓ New System Repair System Type: I II III IV V VI
System Description: CONVENTIONAL GRAVITY
Repair System Description: CONVENTIONAL, GRAVITY
Maintenance Agreement Required Yes ✓ No


House/Mod Home ✓ Mobile Home Business Other
No Bedrooms 3 No Bathrooms 2 No Employees
Slab ✓ Crawl Space Basement w/plumbing Basement w/o plumbing

Water Supply: ☐ Individual ✓ Public ☐ Community

Comments/Conditions: INSTALL LINES ON CONTOUR AS FLAGGED NO DEEPER THAN 24 INCHES

Comments/Conditions:
- 2abol Filter Installed
- S.T Marker Installed
- MH Not located on lot at time of inspection.

INITIAL SITE SKETCH

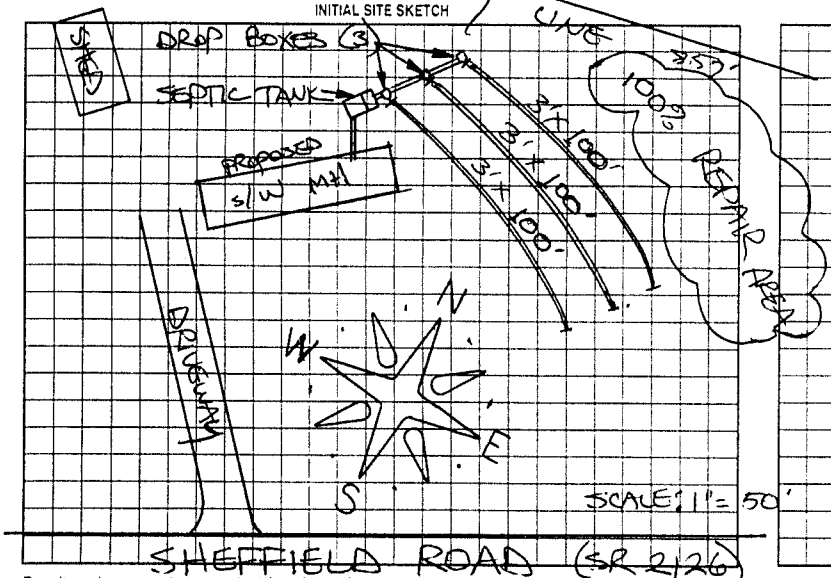

AS BUILT SKETCH

Installed as Shown Per Initial Site Sketch

Permit can be suspended or revoked if any false information is supplied toward securing the permit/any unauthorized changes are made to the site any unauthorized changes are made in the installation of the system. Improvement Permit with plat valid without expiration. Improvement Permit with site plan valid for sixty months. Authorization to Construct is valid for a period equal to that of Improvement Permit - not to exceed sixty months

Signed: R Glen Campbell date 8-21-02 Installed by Brent Galliher

Improvement Permit by: STEVE HEDRICK date 8-21-02 Operation Permit by William C. Johnson date 9/6/02

Authorization to Construct by: STEVE HEDRICK date 8-21-02 Existing System Inspection by: date

HEALTH DEPT COPY WHITE OWNER COPY (FINAL) YELLOW OWNER COPY (INITIAL) PINK