IREDELL COUNTY HEALTH DEPARTMENT

STATESVILLE 704-878-5305 MOORESVILLE 704-664-5281

IMPROVEMENT PERMIT / AUTHORIZATION TO CONSTRUCT / OPERATION PERMIT / EXISTING SYSTEM INSPECTION

PERMIT# 088602 PIN# 4881-11-2161 DATE 4/1/00

OWNER OR CONTRACTOR Tonny Dalton PHONE: Business _____ Home 871-2318

ADDRESS 437 Butler Mill Road

LOCATION 21N through Harmony, R on Butler Mill, ½ 1½ miles on Lt

SUBDIVISION _____ BLOCK / SECTION _____ LOT _____ LOT AREA _____ SITE CLASS _____ DESIGN FLOW _____ L.T.A.R. _____


Septic Tank: _____ Gallons: STB _____ Date _____	☐ New System ☐ Repair	System Type: I. II. III. IV. V. VI	☐ House/Mod. Home	No. Bedrooms 2	Water Supply: ☐ Individual ☐ Public ☐ Community
Pump Tank: _____ Gallons: PT _____ Date _____	System Description:		☑ Mobile Home	No. Bathrooms 2	
Pump Make: _____ Model _____ Serial No. _____	Repair System Description:		☐ Business	No. Employees _____	
Nitrification Field: No Fields _____ Square Feet _____ Linear Feet _____	Maintenance Agreement Required: ☐ Yes ☐ No		☐ Other _____		
No Lines _____ Trench Width _____ Max Trench Bottom Depth _____	Gravel Depth _____	☐ Slab ☐ Crawl Space ☐ Basement w/plumbing ☐ Basement wo/plumbing			

Comments/Conditions:

Comments /Conditions:
System unused for approximately 2 years. Reported repaired in 97-98. Approved for Replacement 2BR MH

INITIAL SITE SKETCH

AS BUILT SKETCH

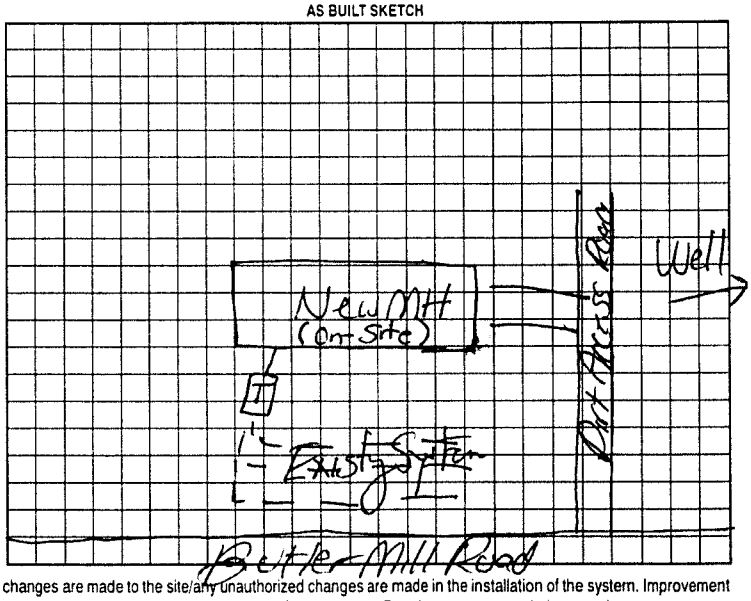

Permit can be suspended or revoked if any false information is supplied toward securing the permit/any unauthorized changes are made to the site/any unauthorized changes are made in the installation of the system. Improvement Permit with plat valid without expiration. Improvement Permit with site plan valid for sixty months. Authorization to Construct is valid for a period equal to that of Improvement Permit – not to exceed sixty months.

Signed: _____ date _____ Installed by: _____

Improvement Permit by: _____ date _____ Operation Permit by: _____ date _____

Authorization to Construct by: _____ date _____ Existing System Inspection by: _____ date 4/1/00

HEALTH DEPT. COPY: WHITE OWNER COPY (FINAL): YELLOW OWNER COPY (INITIAL): PINK