IREDELL COUNTY HEALTH DEPARTMENT

STATESVILLE 704-878-5305 MOORESVILLE 704-664-5281

IMPROVEMENT PERMIT / AUTHORIZATION TO CONSTRUCT / OPERATION PERMIT / EXISTING SYSTEM INSPECTION

PERMIT# 091504 PIN# 4881 19 7773 DATE 8-28-00

OWNER OR CONTRACTOR Brown, Robert PHONE: Business _____ Home (336) 492-7252

ADDRESS 208 Crescent Dr., Mocksville, NC 27028

LOCATION US 21 N, TR MAYBERRY RD, TL KENESAW RD, TL ~~WHITE DEER LANE~~, LAST LOT ON LEFT

SUBDIVISION ~~COUNTRY VILLAGE~~ BLOCK / SECTION _____ LOT 4 LOT AREA _____ SITE CLASS PS DESIGN FLOW 360 L.T.A.R. _____

Septic Tank: ~~EXISTING~~ Gallons: STB _____ Date _____

Pump Tank: _____ Gallons: PT _____ Date _____

Pump Make: _____ Model _____ Serial No. _____

Nitrification Field: No Fields 1 Square Feet _____ Linear Feet ~~EXISTING~~

No Lines Four Trench Width _____ Max Trench Bottom Depth _____ Gravel Depth _____

☐ New System ☐ Repair System Type I (II) III IV V VI

System Description: CONVENTIONAL GRAVITY

Repair System Description: _____

Maintenance Agreement Required: ☐ Yes ☑ No

☐ Slab ☑ Crawl Space ☐ Basement w/plumbing ☐ Basement wo/plumbing

☐ House/Mod. Home No. Bedrooms 3

☑ Mobile Home No. Bathrooms 2

☐ Business No. Employees _____

☐ Other _____


Water Supply: ☐ Individual ☐ Public ☐ Community

Comments:/Conditions:

Comments /Conditions: KEEP MH MINIMUM 5' FROM SYSTEM

INITIAL SITE SKETCH

AS BUILT SKETCH

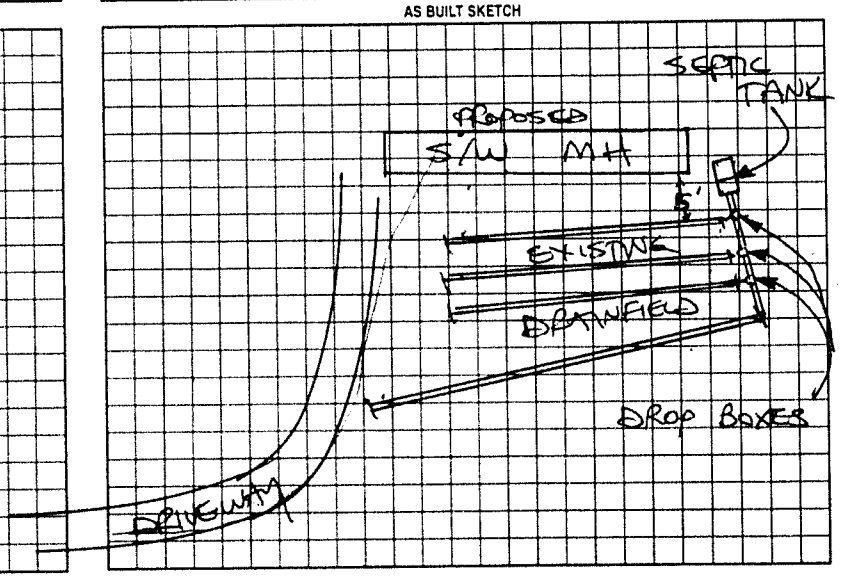

Permit can be suspended or revoked if any false information is supplied toward securing the permit/any unauthorized changes are made to the site/any unauthorized changes are made in the installation of the system. Improvement Permit with plat valid without expiration. Improvement Permit with site plan valid for sixty months. Authorization to Construct is valid for a period equal to that of Improvement Permit -- not to exceed sixty months.

Signed: _____ date _____

Improvement Permit by: _____ date _____

Authorization to Construct by: _____ date _____

Installed by: _____

Operation Permit by: _____ date _____

Existing System Inspection by: STEVE HENDRICK date 8-26-00

HEALTH DEPT COPY WHITE OWNER COPY (FINAL) YELLOW OWNER COPY (INITIAL) PINK