IREDELL COUNTY HEALTH DEPARTMENT

STATESVILLE 704-878-5305 MOORESVILLE 704-664-5281

IMPROVEMENT PERMIT / AUTHORIZATION TO CONSTRUCT / OPERATION PERMIT / EXISTING SYSTEM INSPECTION

PERMIT# 079675 PIN# 4881 29 1802 DATE 3-16-99

OWNER OR CONTRACTOR ELIZABETH ROMERO PHONE: Business Home (704) 492-7763

ADDRESS 167 LANDMARK DRIVE, MOCKSVILLE, NC 27028

LOCATION US 21 N, TR MAYBERRY RD, TL KENNESAW ROAD, LOT ON LEFT ACROSS FROM BOX #558

SUBDIVISION BLOCK / SECTION LOT LOT AREA 3.7 ACRES SITE CLASS PS DESIGN FLOW 360 L.T.A.R. 0.30 GPD/FT2

Septic Tank: 1000 Gallons; STB 620 Date 3-11-99
Pump Tank: Gallons; PT Date
Pump Make: Model Serial No.
Nitrification Field: No Fields 1 Square Feet 1200 Linear Feet 400
No Lines FOUR Trench Width 36" Max Trench Bottom Depth 30" Gravel Depth 12"

☑ New System ☐ Repair System Type: (I) II III IV V VI
System Description: CONVENTIONAL GRAVITY
Repair System Description: CONV. GRAVITY
Maintenance Agreement Required: ☐ Yes ☑ No
☐ Slab ☑ Crawl Space ☐ Basement w/plumbing ☐ Basement wo/plumbing


☐ House/Mod. Home No. Bedrooms 3
☑ Mobile Home No. Bathrooms 2
☐ Business No. Employees
☐ Other

Water Supply: ☐ Individual ☐ Public ☐ Community WELL


Comments/Conditions: ① KEEP SYSTEM MINIMUM 100 FEET FROM WELL ② CONSTRUCT SUBSURFACE INTERCEPT DRAINAGE DITCH AT LOCATION SHOWN BEGINNING 42" DEEP OUT TO DAYLIGHT

Comments/Conditions:

INITIAL SITE SKETCH

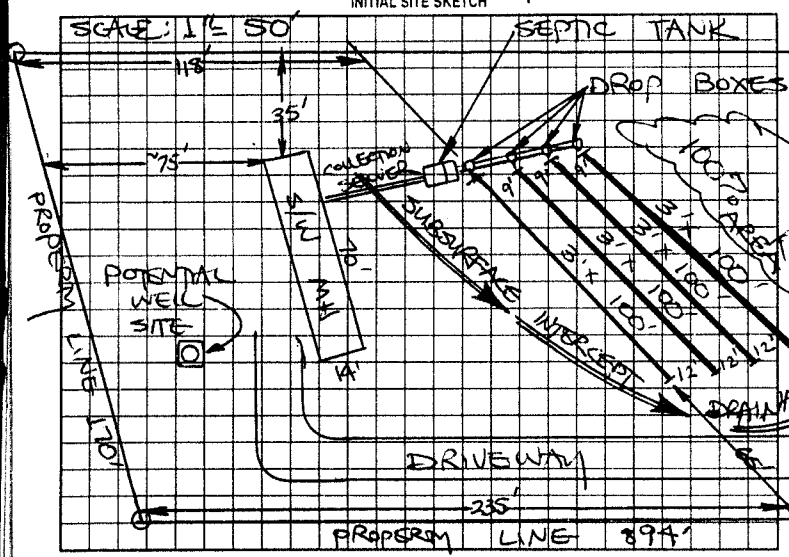

AS BUILT SKETCH

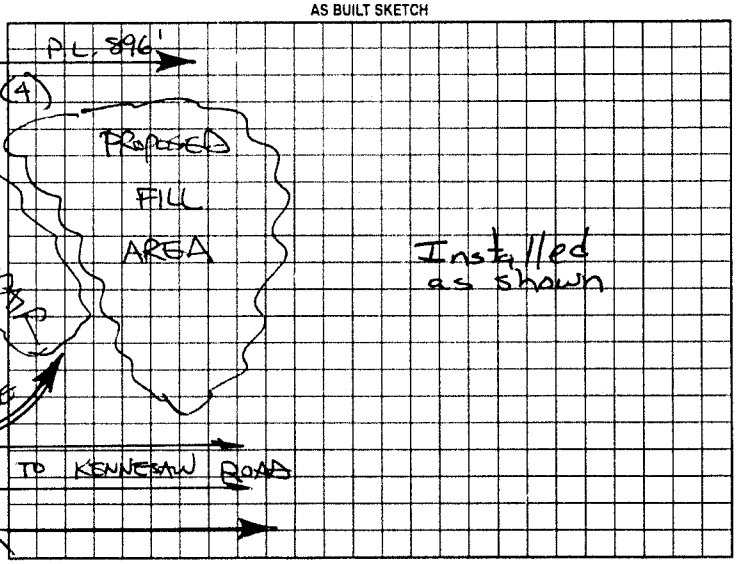

Permit can be suspended or revoked if any false information is supplied toward securing the permit/any unauthorized changes are made to the site/any unauthorized changes are made in the installation of the system. Improvement Permit with plat valid without expiration. Improvement Permit with site plan valid for sixty months. Authorization to Construct is valid for a period equal to that of Improvement Permit - not to exceed sixty months.

Signed: Elizabeth Romero date 3/16/99 Installed by: Tammy Nixon

Improvement Permit by: STEVE HEDRICK date 3-16-99 Operation Permit by: [illegible] date 5-11-99

Authorization to Construct by: STEVE HEDRICK date 3-16-99 Existing System Inspection by: date

HEALTH DEPT COPY WHITE OWNER COPY (FINAL) YELLOW OWNER COPY (INITIAL) PINK