# IREDELL COUNTY HEALTH DEPARTMENT

STATESVILLE 704-878-5305 MOORESVILLE 704-664-5281

## IMPROVEMENT PERMIT / AUTHORIZATION TO CONSTRUCT / OPERATION PERMIT / EXISTING SYSTEM INSPECTION

PERMIT# Repair PIN# DATE 3-18-98

OWNER OR CONTRACTOR David Morgan PHONE: Business Home 910 922 2080

ADDRESS 406 Clarendon Ave Winston-Salem 27106

LOCATION 21N TR Mayberry TL Kenmaw TL @ Country Village 2nd mH on (L)

SUBDIVISION BLOCK / SECTION LOT 2 LOT AREA SITE CLASS. DESIGN FLOW L.T.A.R.

Septic Tank: 1000 Gallons; STB Date

Pump Tank: Gallons; PT Date

Pump Make: Model Serial No.

Nitrification Field: No Fields 1 Square Feet Linear Feet 100

No Lines 2 Trench Width 36in Max Trench Bottom Depth 36in Gravel Depth 24in

☐ New System ☒ Repair System Type: I (II) III, IV, V, VI

System Description:

Repair System Description: Grant Conventional

Maintenance Agreement Required: ☐ Yes ☐ No

☐ House/Mod. Home ☒ Mobile Home ☐ Business ☐ Other

No. Bedrooms 3 No. Bathrooms 2 No. Employees


Water Supply: ☐ Individual ☐ Public ☒ Community

☐ Slab ☒ Crawl Space ☐ Basement w/plumbing ☐ Basement wo/plumbing

Comments:/Conditions: Keep New lines on Contour may substitute speed levelers for new drop boxes for existing lines

Comments:/Conditions:

### INITIAL SITE SKETCH

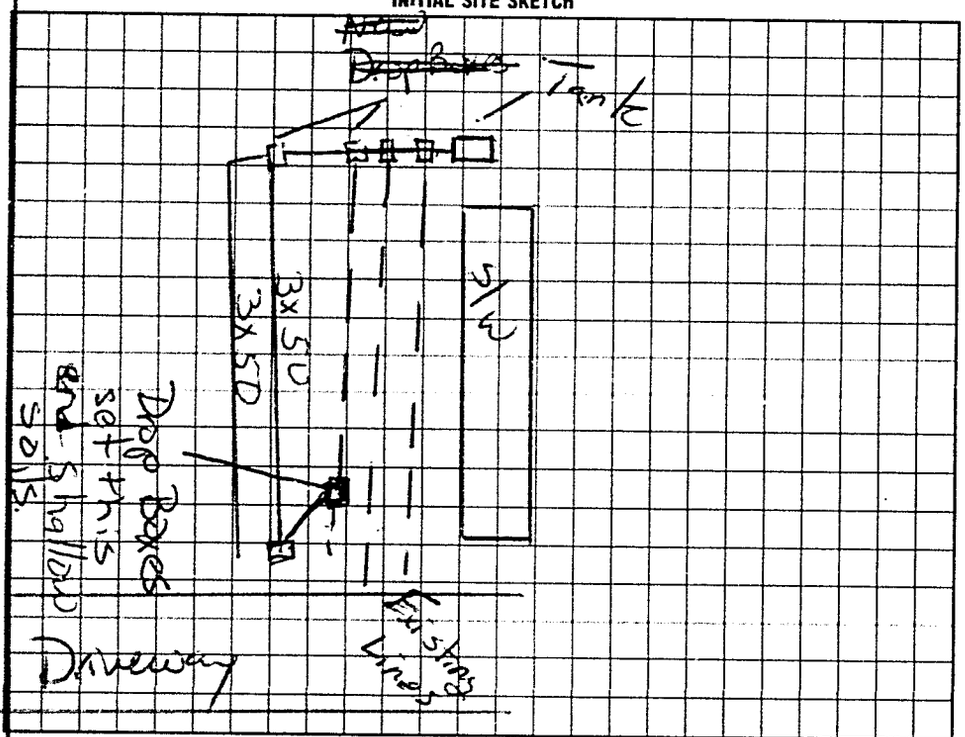


### AS BUILT SKETCH

Installed as shown

I understand that this permit can be suspended or revoked if any false information is supplied toward securing the permit/any unauthorized changes are made to the site/any unauthorized changes are made in the installation of the system. Improvement Permit with plat valid without expiration. Improvement Permit with site plan valid for sixty months. Authorization to Construct is valid for a period equal to that of Improvement Permit – not to exceed sixty months.

Signed: Thomas C. Frye date

Improvement Permit by: Mary C. Ott RS date 3-18-98

Authorization to Construct by: Mary C. Ott RS date 3-18-98

Installed by: Tommy Frye

Operation Permit by: Mary C. Ott RS date 3-25-98

Existing System Inspection by: date

HEALTH DEPT. COPY: WHITE INSPECTION COPY (FINAL): GREEN OWNER COPY (FINAL): YELLOW INSPECTION COPY (INITIAL): PINK OWNER COPY (INITIAL): GOLD

8 0 8 2 0 0