55445

IREDELL COUNTY HEALTH DEPARTMENT

STATESVILLE 704-878-5305 MOORESVILLE 704-664-5281

IMPROVEMENT PERMIT / CERTIFICATE OF COMPLETION / OPERATION PERMIT / EXISTING SYSTEM INSPECTION

PROPERTY DESCRIPTION NO. 20794 DATE 4/7/95 TAX MAP NO. 176-A-72 Watershed: ☐ Yes ☒ No

OWNER OR CONTRACTOR Elvin Bocook PHONE: Business _____ Home _____

ADDRESS Po Box 332 Harmony

LOCATION US 21 N TR MAYBERRY RD, TL KENNESAW RD, TL WHITE DEER LANE, LAST LOT ON LEFT

SUBDIVISION COUNTRY VILLAGE PH BLOCK / SECTION _____ LOT 4 LOT AREA LIMITED SITE CLASS PS DESIGN FLOW 360 L.T.A.R. EXISTING

Septic Tank: 1000 Gallons; STB _____ Date _____

Pump Tank: _____ Gallons; PT _____ Date _____

Pump Make: _____ Model _____ Serial No. _____

Nitrification Field: No Fields 1 Square Feet 720 Linear Feet 240

No Lines 3 Trench Width 36 Max Trench Bottom Depth _____ Gravel Depth 12"

☐ New System ☐ Repair System Type: I II III IV V VI

System Description: CONV EXIST

Repair System Description: _____

Maintenance Agreement Required: ☐ Yes ☐ No

☐ Slab ☒ Crawl Space ☐ Basement w/plumbing ☐ Basement wo/plumbing

☐ House/Mod. Home No. Bedrooms 3

☒ Mobile Home No. Bathrooms 2

☐ Business No. Employees _____


☐ Other _____

Water Supply:
☐ Individual
☒ Community
☐ Public
WELL


Comments:

Comments:
KEEP MH MINIMUM 5' FROM SYSTEM - MH ON SITE AT TIME OF INSPECTION

INITIAL SITE SKETCH

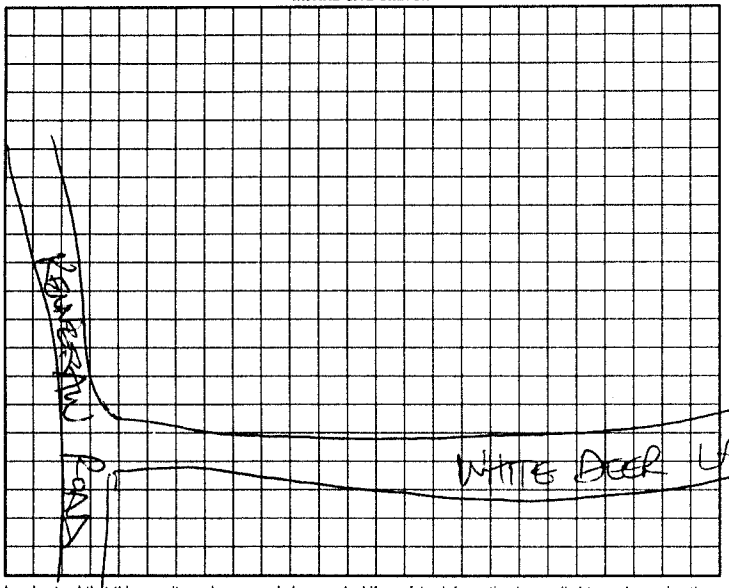

AS BUILT SKETCH

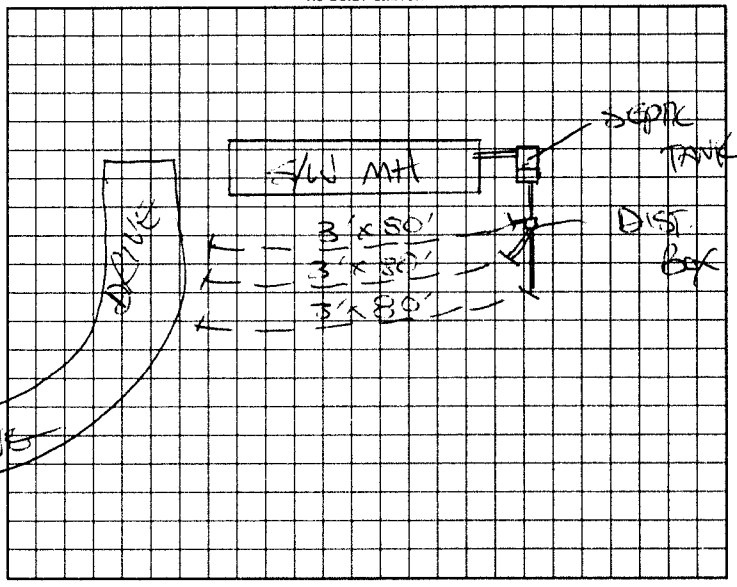

I understand that this permit can be suspended or revoked if any false information is supplied toward securing the permit/any unauthorized changes are made to the site/any unauthorized changes are made in the installation of the system. Improvement Permit is valid for 60 months from date of issuance.

Signed: _____

Improvement Permit by: [redacted] date _____

Existing System Inspection by: STEVE HENDRICK date 4/7/95

Installed by: _____

Certificate of Completion by: _____ date _____

Operation Permit by: _____ date _____

HEALTH DEPT. COPY: WHITE INSPECTION COPY (FINAL): GREEN OWNER COPY (FINAL): YELLOW INSPECTION COPY (INITIAL): PINK OWNER COPY (INITIAL): GOLD